

**SURVEY & REMONUMENTATION**

MAY 27 1997


**COMMISSION**

**LAND CORNER RECORDATION CERTIFICATE**  
**Filing Requirement of Act 74, Mich. P.A. 1970**

For corners in Mason (County) Located In: \_\_\_\_\_ Corner Code # \_\_\_\_\_

|                                      |                           |            |
|--------------------------------------|---------------------------|------------|
| 1. Public Land Survey                | T <u>19N</u> R <u>18W</u> | <u>I 8</u> |
|                                      | T _____ R _____           | _____      |
|                                      | T _____ R _____           | _____      |
|                                      | T _____ R _____           | _____      |
| 2. Property Controlling in Section   | S _____ T _____ R _____   | _____      |
|                                      | S _____ T _____ R _____   | _____      |
| 3. Miscellaneous Property in Section | S _____ T _____ R _____   | _____      |
|                                      | S _____ T _____ R _____   | _____      |

4. Lot No. \_\_\_\_\_, Recorded Plat \_\_\_\_\_  
 5. Private Claims \_\_\_\_\_

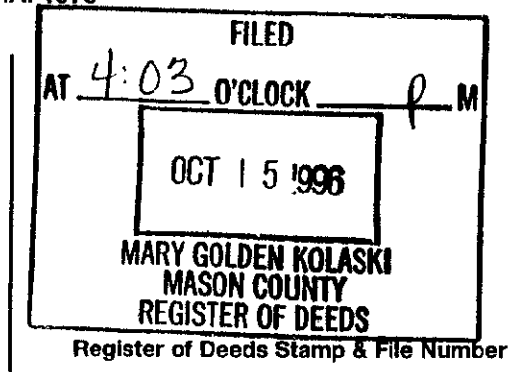

| A  | B  | C  | D  | E | F | G | H  | I | J  | K |
|----|----|----|----|---|---|---|----|---|----|---|
| 2  | 6  | 5  |    |   |   |   |    | 3 |    | 2 |
| 3  |    |    |    |   |   |   |    |   |    |   |
| 4  | 7  | 8  | 9  |   |   |   | 10 |   | 11 |   |
| 5  |    |    |    |   |   |   |    |   |    |   |
| 6  | 18 | 17 | 16 |   |   |   | 15 |   | 14 |   |
| 7  |    |    |    |   |   |   |    |   |    |   |
| 8  | 19 | 20 | 21 |   |   |   | 22 | • | 23 |   |
| 9  |    |    |    |   |   |   |    |   |    |   |
| 10 | 30 | 29 | 28 |   |   |   | 27 |   | 26 |   |
| 11 |    |    |    |   |   |   |    |   |    |   |
| 12 | 31 | 32 | 33 |   |   |   | 34 |   | 35 |   |
| 13 |    |    |    |   |   |   |    |   |    |   |

I, Richard Hays, In a field survey on September, 1996, do hereby certify that under requirements of P.A. 74, Michigan P.A. of 1970, the corner points mentioned in lines 1 and 2 above were in conformance with regulations and rules therefore as required in the current manual of survey instructions of the United States Department of the Interior, Bureau of Land Management or by a decree of a Court of Law and/or that the corner points mentioned in lines 3, 4 and 5 above were in conformance with the rules of the Michigan Board of Professional Surveyors or by a Decree of a Court of Law; established, re-established, monumented, re-monumented, recovered, found as expressed below:

**NOTE: Not more than 4 corners, all in the same town and range, may be recorded on this certificate.**

**A. Description of original monument and accessories and/or subsequent restoration:**

**I-8 QUARTER CORNER COMMON TO SECTIONS 22 & 23**

1838:G.L.O. Set Post 1918:C.E. Mitchell, Book 2, pg 231 1975:Ross #17634, Liber 1, Pg 347  
 20" Hemlock N-80°-W 5 Lks(1) NO WITNESSES Ext. 3/4" Iron Pipe  
 16" Hemlock S-13°-E 12 Lks(2) 10" W. Oak S-24°-W 52.63'(3)  
 1973:Ross #17644, Act 132 8" R. Pine N-35°-E 41.05'(4)  
 1901:Robert O. Towns, Book 4, Liber 313, Pg 223 VOID 8" Tw. W. Pine S-30°-E 80.13'(5)  
 Page 46: Wrong Corner  
 NO WITNESSES 1973:Ross #17634, Act 74 1994:Ross #17634, Act 132, L445, Pg 70  
 VOID NO WITNESSES Distance from SW Corner  
 Wrong Corner to W 1/4 Corner 2452.10

**B. Description of corner evidence found and/or method applied in restoring or reestablishing corner:**

**I-8 QUARTER CORNER COMMON TO SECTIONS 22 & 23**

1995:Found 3/4" Iron Pipe. Condition of Recorded Witnesses are  
 20" Hemlock N-80°-W 5 Lks(1)GONE  
 16" Hemlock S-13°-E 12 Lks(2)GONE  
 10" W. Oak S-20°-W 52.63'(3)GONE  
 8" R. Pine N-35°-E 41.05'(4)GONE  
 Tw 8" W. Pine S-30°-E 80.13'(5)GOOD


Distance from the SW Corner(Mon. Box) to the W 1/4 Corner of Section 23 is 2451.95' Measured  
 Distance from the W 1/4 Corner to the NW Corner(Mon. Box) of Section 23 is 2452.18' Measured

**C. Description of monument for corner and accessories established to perpetuate locating the position of the corner:**

**I-8 QUARTER CORNER COMMON TO SECTIONS 22 & 23**

1996:Replace Found 3/4" Iron Pipe with Standard Mason County Monument with cap, stamped to identify Corner in Monument Box, and is accepted as a careful and faithful re-establishment of position of the Original Corner.  
 16" Trp. Maple N-31°-W 67.56'  
 7" B. Oak N-71°-E 49.10'  
 11" Maple S-81°-W 43.64'  
 8" Tw. Pine S-28°-E 80.06'(5)

Signed by Richard Hays

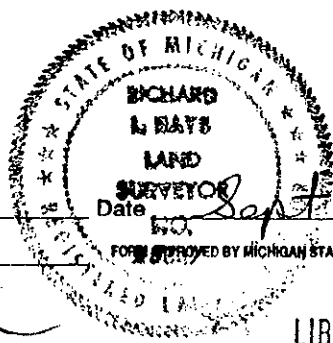

Surveyor's Michigan License No. 25847  
 Date: 10-15-96  
 Peer Group Reviewed and Approved  
Kenneth L. Koss  
 Mason County Surveyor

FORM APPROVED BY MICHIGAN STATE BOARD OF PROFESSIONAL SURVEYORS, JAN. 28, 1971  
 REVISED MAY 14, 1978  
 REVISED JAN 1978

LIBER 4 PAGE