


DEC 18 1995

COMMISSION

**LAND CORNER RECORDATION CERTIFICATE**  
**Filing Requirement of Act 74, Mich. P.A. 1970**

For corners in Mason <small>(County)</small>	Located In:	Corner Code #
1. Public Land Survey	T 19N R 18W	I-9
	T _____ R _____	_____
	T _____ R _____	_____
	T _____ R _____	_____
2. Property Controlling in Section	S _____ T _____ R _____	_____
	S _____ T _____ R _____	_____
3. Miscellaneous Property in Section	S _____ T _____ R _____	_____
	S _____ T _____ R _____	_____
4. Lot No. _____, Recorded Plat _____		
5. Private Claims _____		

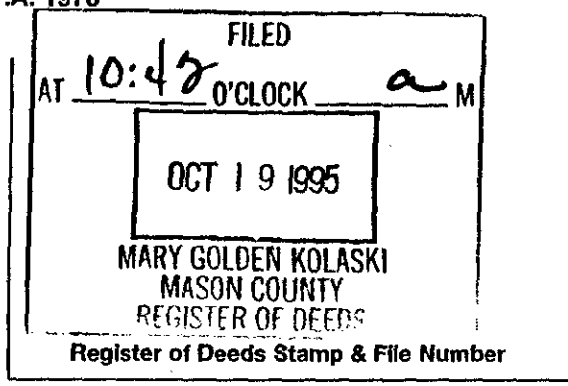

I, Richard Hays, in a field survey on September, 1995, do hereby certify that under requirements of P.A. 74, Michigan P.A. of 1970, the corner points mentioned in lines 1 and 2 above were in conformance with regulations and rules therefore as required in the current manual of survey instructions of the United States Department of the Interior, Bureau of Land Management or by a decree of a Court of Law and/or that the corner points mentioned in lines 3, 4 and 5 above were in conformance with the rules of the Michigan Board of Professional Surveyors or by a Decree of a Court of Law; established, re-established, monumented, re-monumented, recovered, found as expressed below:

A	B	C	D	E	F	G	H	I	J	K	L	M
2	5	5						3			2	
3												
4	7	8	9	10	11	12						
5												
6	18	17	16	15	14	13						
7												
8	19	20	21	22	23	24						
9												
10	30	29	28	27	26	25						
11												
12	31	32	33	34	35	36						
13												

**NOTE: Not more than 4 corners, all in the same town and range, may be recorded on this certificate.**

**A. Description of original monument and accessories and/or subsequent restoration:  
 I-9 CORNER FOR SECTIONS 22, 23, 26 & 27, T19N, R18W**

- |                         |                                 |                             |                               |
|-------------------------|---------------------------------|-----------------------------|-------------------------------|
| 1838 G.L.O. Sibley      | 1918 C.E. Mitchell              | 6) 12" W. Oak SE 79.63'     | 1984 Act 132 Flu Harty #18223 |
| 1) 16" Beech N-42°-W 27 | Book 2, Pg 231 found bolt       | 7) 30" R. Oak SW 61.00'     | Iron Mon. Box                 |
| 2) 10" Beech S-61°-E 40 | 3) 30" Pine Stump S-17°-E 43.5' | 1975 M.C.R.C. Mon. Box Iron | 12) P.Pole N-61°-E 61.04'     |
| 1901 Robert O. Towns    | 4) 4" Oak S-58°-W 61.0'         | 8) same as 7                | 13) same as 6 & 9             |
| Book 4, Pg 46           | 1972 Ross #17634 L.C.R.C.       | 9) same as 6                | 14) 18" Pal S-40°-W 64.29'    |
| Found Stake No Witness  | Liber 1, Pg 19 3/4" Iron        | 10) same as 5               |                               |
|                         | 13.3 West of N & S Road         | 11) P.Pole NE 60.00'        |                               |
|                         | 5) 10" Tw. Oaks NW 79.93'       |                             |                               |

**B. Description of corner evidence found and/or method applied in restoring or reestablishing corner:  
 I-9 CORNER FOR SECTIONS 22, 23, 26, & 27, T19N, R18W**


Sept. 1995 found iron in monument box 13 feet west of centerline N & S road. I found no other evidence to dispute this corner.

Condition of Recorded Witnesses is #1 Gone, #2 Gone, #3 Gone, #4 Same as #7, #5 Gone, #6 Found, #7 Found, #8 Found, #9 Found, #10 Gone, #11 Gone, #12 Found, #13 Found, #14 Gone.

**C. Description of monument for corner and accessories established to perpetuate locating the position of the corner:  
 I-9 CORNER FOR SECTIONS 22, 23, 26, & 27, T19N, R18W**

I replaced Iron with a 5/8" Re-Rod 24" long with an aluminum cap stamped Mason County Monument in Monument Box and is accepted as a careful and faithful reestablishment of the position of the original corner.

- |                               |                                |
|-------------------------------|--------------------------------|
| #12 P. Pole N-60°-E 61.05     | #7 30" TW W Oak S-66°-W 60.92' |
| #13 21" W. Oak S-49°-E 79.66' | 40" Beech N-67°-W 147.28'      |

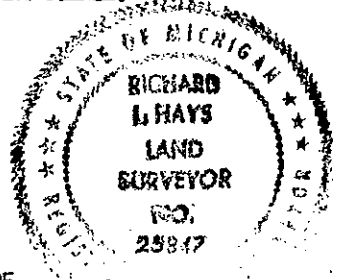

Signed by Richard Hays

Date October 17, 1995

Surveyor's Michigan License No. 25847

Peer Group Reviewed and Approved  
 Date: 10-12-95  
Kenneth L. Ross  
 Mason County Surveyor

FORM APPROVED BY MICHIGAN STATE BOARD OF PROFESSIONAL SURVEYORS, JAN. 28, 1971  
 REVISED MAY 14, 1975  
 REVISED JAN., 1983