

DEC 18 1995

COMMISSION

LAND CORNER RECORDATION CERTIFICATE

Filing Requirement of Act 74, Mich. P.A. 1970

For corners in

Mason _____ Located In: _____ Corner Code # _____
 (County)


1. Public Land Survey T19N R 18W I-13
 T _____ R _____
 T _____ R _____
 T _____ R _____

2. Property Controlling S _____ T _____ R _____
 in Section S _____ T _____ R _____

3. Miscellaneous S _____ T _____ R _____
 Property in Sec. S _____ T _____ R _____

4. Lot No. _____, Recorded Plat _____

5. Private Claims _____

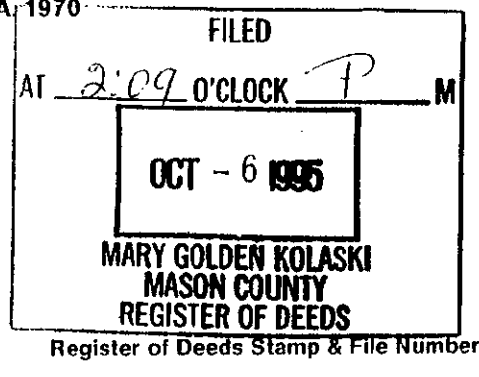

	A	B	C	D	E	F	G	H	I	J	K	L	M
2	6		5		4		3		2				
3													
4	7		8		9		10		11		12		
5													
6	18		17		16		15		14		13		
7													
8	19		20		21		22		23		24		
9													
10	30		29		28		27		26		25		
11													
12	31		32		33		34		35		36		
13													

I, Richard Hays, in a field survey on September, 1995, do hereby certify that under requirements of P.A. 74, Michigan P.A. of 1970, the corner points mentioned in lines 1 and 2 above were in conformance with regulations and rules therefore as required in the current manual of survey instructions of the United States Department of the Interior, Bureau of Land Management or by a decree of a Court of Law and/or that the corner points mentioned in lines 3, 4 and 5 above were in conformance with the rules of the Michigan Board of Land Surveyors or by a Decree of a Court of Law; established, re-established, monumented, re-monumented, recovered, found as expressed below:

NOTE: Not more than 4 corners, all in the same town and range, may be recorded on this certificate.

A. Description of original monument and accessories and/or subsequent restoration:

I-13 SECTION CORNER COMMON TO SECTIONS 34 & 35
 1838:G.L.O. Survey MASON COUNTY 1991:Act 74, Liber 3
 24" W. Pine N-73°-W 41 Lks(1) ROAD COMMISSION Page 41, Set Mon. Box
 16" W. Pine N-28°-E 57 Lks(2) P. Pole NW 55.4'(3) P. Pole N-15°-W 54.03'(6)
 20" Oak SW 69.8'(4) 15" Cherry N-50°-E 64.72'(7)
 1918:John A. Mitchell Survey Conc Mon SW 61.3'(5) T. Pole S-70°-E 81.05'(8)
 Book 2, Page 231
 No Witnesses.

B. Description of corner evidence found and/or method applied in restoring or reestablishing corner:

I-13 SECTION CORNER COMMON TO SECTIONS 34 & 35
 1995:Found 3/8" Re-Rod in Monument Box. Found no other evidence to dispute this location. Condition of the Recorded Witnesses are as follows:


24" W. Pine	N-73°-W	41 Lks (1)	GONE
16" W. Pine	N-28°-E	57 Lks (2)	GONE
P. Pole	NW	55.4' (3)	FOUND
20" Oak	SW	69.8' (4)	FOUND
Conc. Mon.	SW	61.3' (5)	NOT FOUND
P. Pole	N-15°-W	54.03' (6)	FOUND
15" Cherry	N-50°-E	64.72' (7)	FOUND
T. Pole	S-70°-E	81.05' (8)	GONE

C. Description of monument for corner and accessories established to perpetuate locating the position of the corner:

I-13 SECTION CORNER COMMON TO SECTIONS 34 & 35
 1995:Replaced 3/8" Re-Rod with 5/8" Re-Rod, 24" long with a Aluminum Cap stamped MASON COUNTY MONUMENT in Monument Box and is accepted as a careful and faithful perpetuation of the position of the Original Corner.

30" W. Oak	S-21°-W	71.19' (4)
Power Pole	S-68°-E	85.00'
20" Cherry	N-60°-E	64.83' (7)
Power Pole	N-11°-W	54.00' (3 & 6)

NE Corner of Section 03
 Monument Box East 18.23'

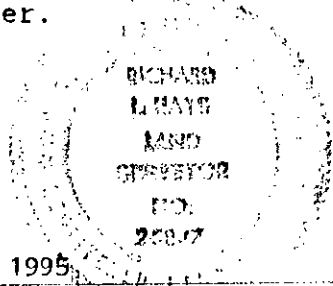

Signed by Richard Hays LIBER 3 PAGE 310 Date September 28, 1995

Surveyor's Michigan License No. 25847 Peer Group Reviewed and Approved Date: 10/28/95
 Kenneth J. Eves
 Mason County Surveyor