

DEC 18 1995

LAND CORNER RECORDATION CERTIFICATE
Filing Requirement of Act 74, Mich. P.A. 1970

For corners in COMMISSION
Mason
(County)

Located In:

Corner Code #

- | | | |
|---------------------------------------|---------------------------|------------|
| 1. Public Land Survey | T <u>19N</u> R <u>18W</u> | <u>J-5</u> |
| | T _____ R _____ | _____ |
| | T _____ R _____ | _____ |
| | T _____ R _____ | _____ |
| 2. Property Controlling in Section | S _____ T _____ R _____ | _____ |
| | S _____ T _____ R _____ | _____ |
| 3. Miscellaneous Property in Section | S _____ T _____ R _____ | _____ |
| | S _____ T _____ R _____ | _____ |
| 4. Lot No. _____, Recorded Plat _____ | | |
| 5. Private Claims _____ | | |

FILED
AT 10:43 O'CLOCK a M
OCT 19 1995
MARY GOLDEN KOLASKI
MASON COUNTY
REGISTER OF DEEDS
Register of Deeds Stamp & File Number

	A	B	C	D	E	F	G	H	I	J	K	L	M
2	6		5		4		3		2				
3													
4	7		8		9		10		11				12
5													
6	18		17		16		15		14				13
7													
8	19		20		21		22		23				24
9													
10	30		29		28		27		26				25
11													
12	31		32		33		34		35				36
13													

I, Richard L. Hays, in a field survey on September, 19 95
do hereby certify that under requirements of P.A. 74, Michigan P.A. of 1970, the corner points mentioned in lines 1 and 2 above were in conformance with regulations and rules therefore as required in the current manual of survey instructions of the United States Department of the Interior, Bureau of Land Management or by a decree of a Court of Law and/or that the corner points mentioned in lines 3, 4 and 5 above were in conformance with the rules of the Michigan Board of Professional Surveyors or by a Decree of a Court of Law; established, re-established, monumented, re-monumented, recovered, found as expressed below:

NOTE: Not more than 4 corners, all in the same town and range, may be recorded on this certificate.

A. Description of original monument and accessories and/or subsequent restoration:

- J-5 QUARTER CORNER COMMON TO SECTION 11 AND 14, T19N-R18W
1838:G.L.O. Survey Sibley 1975:MCRC
14" Beech Corner Tree 12" Beech N-30°-W 49.25'(4)
P. Pole S-45°-E 66.05'(5)
Tw. 16" Maple N-80°-W 61.55'(6)
- 1974:Nordlund Survey RLS#16345 LCRC Liber 1, Pg 240
Set 1"x30" Re-Bar midway between Section Corners 1981:Wilcox #14102 LCRC L2, Pg 93
12" Beech N-30°-W 49.25'(1) 6" Ash S-60°-W 39.47'(7)
P. Pole S-45°-E 66.05'(2) Tw. 16" Maple N-80°-W 61.55'(9)
Tw. 16" Beech N-80°-W 61.55'(3) 10" Maple N-16°-E 42.68'(10)

B. Description of corner evidence found and/or method applied in restoring or reestablishing corner:


- J-5 QUARTER CORNER COMMON TO SECTION 11 AND 14, T19N-R18W
1995:Found 3/4" Iron Bar in centerline of road. (North and South)
Found no other evidence to dispute this location. Condition of the Recorded Witnesses are as follows:
FOUND 12" Beech N-30°-W 49.25'(1)(4)
FOUND P. Pole S-45°-E 66.05'(2)(5)(8)
FOUND Tw. 16" Maple N-80°-W 61.55'(3)(6)(9) Maple was original mislabeled as a Beech
FOUND 6" Ash S-60°-W 39.47'(7)
FOUND 10" Maple N-16°-E 42.68'(10)

C. Description of monument for corner and accessories established to perpetuate locating the position of the corner:

- J-5 QUARTER CORNER COMMON TO SECTION 11 AND 14, T19N-R18W
1995:Set a 5/8" Re-Rod, 24" long with an Aluminum Cap stamped MASON COUNTY MONUMENT over 1" Iron Bar and is accepted as a careful and faithful perpetuation of the position of the Original Corner.
20" Tw. Maple N-77°-W 61.58'(3)
Power Pole S-45°-E 66.13'(2)
10" Maple N-18°-W 42.68'(10)
6" Ash S-64°-W 39.45'(7)

Signed by Richard Hays
Surveyor's Michigan License No. 25847

Date October 17, 1995

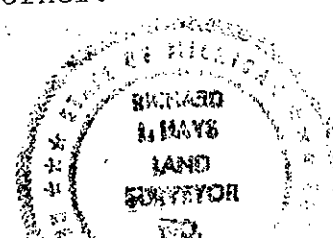

FORM APPROVED BY MICHIGAN STATE BOARD OF PROFESSIONAL SURVEYORS, JAN. 28, 1971
REVISED MAY 14, 1975
REVISED JAN., 1983

Peer Group Reviewed and Approved
Date: 10-17-95
Kenneth L. Row
Mason County Surveyor