

DEC 18 1995

COMMISSION

LAND CORNER RECORDATION CERTIFICATE

Filing Requirement of Act 74, Mich. P.A. 1970

FILED  
AT 10:48 O'CLOCK a M  
OCT 19 1995  
MARY GOLDEN KOLASKI  
MASON COUNTY  
REGISTER OF DEEDS  
Register of Deeds Stamp & File Number

For corners in Mason (County)	Located In:	Corner Code #
1. Public Land Survey	T 19N R 18W	J-7
	T R	
	T R	
	T R	
2. Property Controlling in Section	S T R	
	S T R	
3. Miscellaneous Property in Section	S T R	
	S T R	

4. Lot No. \_\_\_\_\_, Recorded Plat \_\_\_\_\_  
5. Private Claims \_\_\_\_\_

I, Richard Hays, in a field survey on September, 1995  
do hereby certify that under requirements of P.A. 74, Michigan P.A. of 1970, the corner points mentioned in lines 1 and 2 above were in conformance with regulations and rules therefore as required in the current manual of survey instructions of the United States Department of the Interior, Bureau of Land Management or by a decree of a Court of Law and/or that the corner points mentioned in lines 3, 4 and 5 above were in conformance with the rules of the Michigan Board of Professional Surveyors or by a Decree of a Court of Law; established, re-established, monumented, re-monumented, recovered, found as expressed below:

NOTE: Not more than 4 corners, all in the same town and range, may be recorded on this certificate.

A	B	C	D	E	F	G	H	I	J	K	L	M
2	6	5	4	3	2							
3												
4	7	8	9	10	11	12						
5												
6	18	17	16	15	14	13						
7												
8	19	20	21	22	23	24						
9												
10	30	29	28	27	26	25						
11												
12	31	32	33	34	35	36						
13												

A. Description of original monument and accessories and/or subsequent restoration:

J-7 QUARTER CORNER COMMON TO SECTIONS 14 AND 23, T19N-R18W

1838:G.L.O. Survey Sibley	1974:Nordlund Survey RLS #16345
8" Beech S-49°-W 10 lks(1)	Found 3/4" bent Iron, re-established Corner
8" Beech S-46°-E 32 lks(2)	halfway and on line between Section Corners.
	Liber 1, Page 239 Set Corner.
1974:M.C.R.C. Set 1"x30" Iron Bar	20" Beech N-45°-W 18.85' (6)
20" Beech N-45°-W 18.85' (3)	Tw. 20" Oak S-70°-W 44.10' (7)
Tw. 20" Oak S-70°-W 44.10' (4)	12" R. Pine S-45°-E 58.30' (8)
12" R. Pine S-45°-E 58.30' (5)	1991 Act 132 John Schulke #30894 L. 403, Pg. 1223

B. Description of corner evidence found and/or method applied in restoring or reestablishing corner:

J-7 QUARTER CORNER COMMON TO SECTIONS 14 AND 23, T19N-R18W

1995:Found 1" Iron Bar. Found no other evidence to dispute this location.  
Condition of the Recorded Witnesses are as follows:


8" Beech S-49°-W 10 lks (1)	GONE
8" Beech S-46°-E 32 lks (2)	GONE
20" Beech N-45°-W 18.85' (3) (6)	GONE
Tw. 20" Oak S-70°-W 44.10' (4) (7)	FOUND
12" R. Pine S-45°-E 58.30' (5) (8)	GONE

C. Description of monument for corner and accessories established to perpetuate locating the position of the corner:

J-7 QUARTER CORNER COMMON TO SECTIONS 14 AND 23, T19N-R18W

1995:Replaced the 1" Iron Rod with 5/8" Re-Rod, 24" long with an Aluminum Cap stamped MASON COUNTY MONUMENT and is accepted as a careful and faithful perpetuation of the position of the Original Corner.

12" R. Pine N-62°-W 43.80'	
Tw. 20" Oak S-75°-W 44.10' (4)	
Power Pole East 29.18'	
12" R. Pine S-45°-E 64.38'	
Capped Iron East 33.00'	

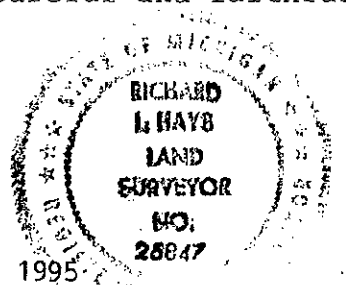

Signed by \_\_\_\_\_ Date October 17, 1995

Surveyor's Michigan License No. 25847

FORM APPROVED BY MICHIGAN STATE BOARD OF PROFESSIONAL SURVEYORS, JAN. 26, 1971  
REVISED MAY 14, 1975  
REVISED JAN., 1983

Peer Group Reviewed  
and Approved  
Date: 10-17-95  
Kenneth I. Ross  
Mason County Surveyor