


DEC 18 1995

COMMISSION

LAND CORNER RECORDATION CERTIFICATE

Filing Requirement of Act 74, Mich. P.A. 1970

For corners in Mason _____ (County)	Located In: _____	Corner Code # J-9
1. Public Land Survey	T <u>19N</u> R <u>18W</u>	_____
	T _____ R _____	_____
	T _____ R _____	_____
	T _____ R _____	_____
2. Property Controlling in Section	S _____ T _____ R _____	_____
	S _____ T _____ R _____	_____
3. Miscellaneous Property in Section	S _____ T _____ R _____	_____
	S _____ T _____ R _____	_____

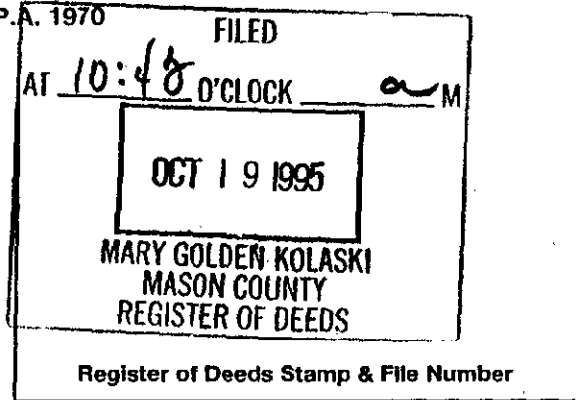

4. Lot No. _____, Recorded Plat _____
5. Private Claims _____

I, Richard Hays, in a field survey on September, 19 95, do hereby certify that under requirements of P.A. 74, Michigan P.A. of 1970, the corner points mentioned in lines 1 and 2 above were in conformance with regulations and rules therefore as required in the current manual of survey instructions of the United States Department of the Interior, Bureau of Land Management or by a decree of a Court of Law and/or that the corner points mentioned in lines 3, 4 and 5 above were in conformance with the rules of the Michigan Board of Professional Surveyors or by a Decree of a Court of Law; established, re-established, monumented, re-monumented, recovered, found as expressed below:

NOTE: Not more than 4 corners, all in the same town and range, may be recorded on this certificate.

A	B	C	D	E	F	G	H	I	J	K	L	M
2	6	5	4	3	2	1						
3												
4	7	6	5	4	3	2	1					
5												
6	18	17	16	15	14	13	12	11	10	9	8	7
7												
8	19	20	21	22	23	24	25	26	27	28	29	30
9												
10	30	29	28	27	26	25	24	23	22	21	20	19
11												
12	31	32	33	34	35	36	35	34	33	32	31	30
13												

A. Description of original monument and accessories and/or subsequent restoration:


J-9 QUARTER CORNER COMMON TO SECTIONS 23 AND 26, T19N-R18W
 1838:G.L.O. Survey 1975:M.C.R.C. 1981:Act 132, L 277, Pg 694
 10" Beech S-41°-W 31 lks(1) Iron in Mon. Box Bolt in Monument Box
 8" Beech N-46°-E 16 lks(2) 15" R. Oak NW 71.11'(6) P. Pole SW 40.2'(10)
 1972:Act 132, Liber 1, Pg 102 12" Maple NE 92.15'(7) SE HSE COR. NE 102.2'(11)
 Rail Road Spike P. Pole SW 40.28'(8) NE HSE COR. SE 103.0'(12)
 24" R. Oak Northwest 71.00'(3) NE Cor. Porch SE 95.17'(9)
 Power Pole Southwest 40.28'(4)
 Eagles Sign Southeast 34.20'(5)

B. Description of corner evidence found and/or method applied in restoring or reestablishing corner:

J-9 QUARTER CORNER COMMON TO SECTIONS 23 AND 26, T19N-R18W
 1995:Found Iron in Monument Box. Found no other evidence to dispute this location. Condition of the Recorded Witnesses are as follows:
 10" Beech S-41°-W 31 lks (1) GONE
 8" Beech N-46°-E 16 lks (2) GONE
 24" R. Oak Northwest 71.00'(3) FOUND
 Power Pole Southwest 40.28'(4) (8) (10) FOUND
 Eagles Sign Southeast 34.20'(5) GONE
 15" R. Oak Northwest 71.11'(6) FOUND
 12" Maple Northeast 92.15'(7) GONE
 NE Corner Porch Southeast 95.17'(9) FOUND
 SE Corner House Northeast 102.2'(11) NOT USED
 NE Corner House Southeast 103.0'(12) NOT USED

C. Description of monument for corner and accessories established to perpetuate locating the position of the corner:

J-9 QUARTER CORNER COMMON TO SECTIONS 23 AND 26, T19N-R18W
 1995:Replaced Iron with 5/8" Re-Rod, 24" long with Aluminum Cap stamped MASON COUNTY MONUMENT in Monument Box and is accepted as a careful and faithful perpetuation of the position of the Original Corner.
 Power Pole S-50°-W 40.07' (10)
 9" Spruce S-40°-E 43.55'
 30" R. Oak N-60°-W 71.80' (6)
 NE Corner Porch S-32°-E 95.17' (9)
 Guy Pole N-78°-E 103.58'

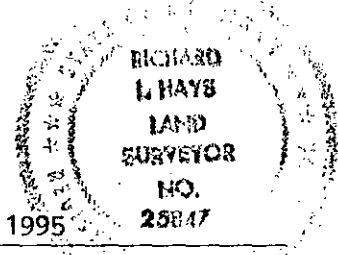

Signed by Richard Hays
 Surveyor's Michigan License No. 25847

Date October 17, 1995

FORM APPROVED BY MICHIGAN STATE BOARD OF PROFESSIONAL SURVEYORS, JAN. 28, 1971
 REVISED MAY 14, 1975
 REVISED JAN., 1983

LIBER 3 PAGE 329
 Peer Group Reviewed and Approved
 Date: 10-17-95
Kenneth L. Ross
 Mason County Surveyor