

DEC 18 1995

COMMISSION LAND CORNER RECORDATION CERTIFICATE
Filing Requirement of Act 74, Mich. P.A. 1970.

For corners in

Mason (County) Located In: Corner Code: #

1. Public Land Survey T 19N R 18W J-13
T R
T R
T R

2. Property Controlling S T R
in Section S T R

3. Miscellaneous S T R
Property in Sec. S T R

4. Lot No. , Recorded Plat

5. Private Claims

FILED

AT 2:11 O'CLOCK P M

OCT - 6 1995

MARY GOLDEN KOLASKI
MASON COUNTY
REGISTER OF DEEDS

Register of Deeds Stamp & File Number

I, Richard Hays, in a field survey on September 19 95 do hereby certify that under requirements of P.A. 74, Michigan P.A. of 1970, the corner points mentioned in lines 1 and 2 above were in conformance with regulations and rules therefore as required in the current manual of survey instructions of the United States Department of the Interior, Bureau of Land Management or by a decree of a Court of Law and/or that the corner points mentioned in lines 3, 4 and 5 above were in conformance with the rules of the Michigan Board of Land Surveyors or by a Decree of a Court of Law; established, re-established, monumented, re-monumented, recovered, found as expressed below:

NOTE: Not more than 4 corners, all in the same town and range, may be recorded on this certificate.

	A	B	C	D	E	F	G	H	I	J	K	L	M
2	6		5		4		3		2		1		
3													
4	7		8		9		10		11		12		
5													
6	18		17		16		15		14		13		
7													
8	19		20		21		22		23		24		
9													
10	30		29		28		27		26		25		
11													
12	31		32		33		34		35		36		
13													

A. Description of original monument and accessories and/or subsequent restoration:

J-13 QUARTER CORNER TO SECTION 35
1838:G.L.O. Survey 1991:Act 74
6" Beech N-81°-E 19 Lks(1) Set Monument Box over 1" Iron Pipe
5" B. Oak N-41°-W 16 Lks(2) Power Pole N-20°-W 62.65'(7)
Tel. Pole S-21°-E 33.30'(8)
St. Sign Post N-40°-E 54.00'(9)


1972:Act 74 1/2" Iron
Tel. Pole SE 33.95'(3)
Rd. Sign NE 54.00'(4)
Power Pole NW 62.35'(5)
Stand Pipe in Dow Box SSW 105.77'(6)

B. Description of corner evidence found and/or method applied in restoring or reestablishing corner:

J-13 QUARTER CORNER TO SECTION 35
1995:Found 1" Iron in Monument Box. Found no other evidence to dispute this location. Condition of the Recorded Witnesses are as follows:
6" Beech N-81°-E 19 Lks(1) GONE
5" B. Oak N-41°-W 16 Lks(2) GONE
Tel. Pole SE 33.95'(3) FOUND
Rd. Sign NE 54.00'(4) GONE
Power Pole NW 62.35'(5) FOUND
Stand Pipe in Dow Box SSW 105.77'(6) NOT FOUND
Power Pole N-20°-W 62.65'(7) FOUND
Tel. Pole S-21°-E 33.30'(8) FOUND
St. Sign Post N-40°-E 54.00'(9) GONE

C. Description of monument for corner and accessories established to perpetuate locating the position of the corner:

J-13 QUARTER CORNER TO SECTION 35
1995:Replaced 1" Iron with 5/8" Re-Rod, 24" long with an Aluminum Cap stamped MASON COUNTY MONUMENT in monument box and is accepted as a careful and faithful perpetuation of the position of the Original Corner.
25" Twin B. Oak N-46°-E 114.85'
Power Pole N-25°-W 62.61' (5)(7)
13" White Pine S-48°-W 44.83'
Tel. Pole S-24°-E 33.32' (3)(8)
1/4 Corner Section 2 Monument Box EAST 17.93'

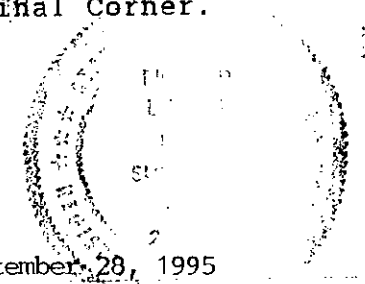

Signed by Richard Hays Date September 28, 1995
Surveyor's Michigan License No. 25847

LIBER 3 PAGE 312

Peer Group Reviewed and Approved
Date: 9-28-95
Kenneth L. Gross
Mason County Surveyor