

SURVEY & REMONUMENTATION


MAY 07 1997

COMMISSION

LAND CORNER RECORDATION CERTIFICATE
Filing Requirement of Act 74, Mich. P.A. 1970

For corners in

Mason (County)	Located in:	Corner Code #
1. Public Land Survey	T 19N R 18W	M-01 ✓
	T 19N R 17W	A-01
	T R	
	T R	
2. Property Controlling in Section	S T R	
	S T R	
3. Miscellaneous Property in Sec.	S T R	
	S T R	

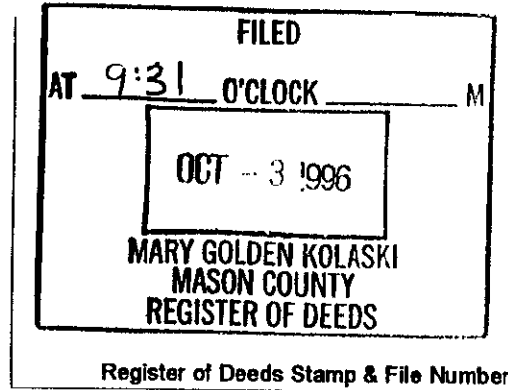

4. Lot No. _____, Recorded Plat _____
5. Private Claims _____

I, Sammy S. Barnett, in a field survey on Sept., 19 96 do hereby state that under requirements of P.A. 74, Michigan P.A. of 1970, the corner points mentioned in lines 1 and 2 above were in conformance with regulations and rules therefore as required in the current manual of survey instructions of the United States Department of the Interior, Bureau of Land Management or by a decree of a Court of Law and /or that the corner points mentioned in lines 3, 4 and 5 above were in conformance with the rules of the Michigan Board of Land Surveyors or by a Decree of a Court of Law; established, re-established, monumented, recovered, found as expressed below:

NOTE: Not more than 2 corners, all in the same town and range, may be recorded on this certificate.

	A	B	C	D	E	F	G	H	I	J	K	L
1												
2		6		5		4		3		2		1
3												
4		7		8		9		10		11		12
5												
6		18		17		16		15		14		13
7												
8		19		20		21		22		23		24
9												
10		30		29		28		27		26		25
11												
12		31		32		33		34		35		36
13												

A. Description of original monument and accessories and/or subsequent restoration:

M-01 & A-01 Corner Common to section 1 T19N. R18W Hamlin & section 6 T19N. R17W (Victory) same corner 1837 Mullett & Brookfield G.L.O.
Set intersection cor. to T19 & 20N & R17 & 18W

# 1 Hemlock 10" S59E 30 lks (19.80')	1965 K.B. Stephens File H-125	# 5 Poplar 4' S11W 49'
# 2 Hemlock 10" N23W 29 lks. (19.14')	Existing iron pipe. no witnesses	# 6 Cherry 4" S34 1/2 W 72.0'
1943 K.B. Stephens Drawing H-28	Undated survey by R. Lunde MCRC	1965 R. Griffin found pipe & set standard Mon.
Monument not given	Monument not given	# 7 Maple 6" N38E 55.00' dock spike NW side
No witnesses	# 3 Poplar 6" N48E 69.0'	# 8 Power Pole S88E 104.42' spike N. side
3432' S. to 1/4 corner	# 4 Poplar 5" S17 1/2 E no dist.	# 9 Beech 5" S61E 55.47' dock spike NE side
		# 10 Maple 5" S40W 93.78' dock spike SE side
		# 11 Cherry 9" N26W 72.15 same as # 6

B. Description of corner evidence found and/or method applied in restoring or reestablishing corner:

M-01 & A-01 Corner Common to section 1 T19N. R18W(Hamlin)& section 6 T19N. R17W (Victory) same corner
On Sept. 10, I found the 5" square monument 1' above the ground in E-W Power line. I found no evidence to dispute this location. The condition of the recorded witnesses are:

# 1 Gone	# 8 Power pole S88E 104.42' spike in N. side
# 2 Gone	# 9 Found stump
# 3 Gone	# 10 Found stump
# 4 Gone	# 11 Gone same as # 6
# 5 Gone	
# 6 Gone	
# 7 Gone	

C. Description of monument for corner and accessories established to perpetuate locating the position of the corner:


M-01 & A-01 Corner Common to section 1 T19N. R18W(Hamlin)& section 6 T19N. R17W (Victory) same corner
I left the 5" square concrete monument as a substantial monument and accepted this location as a careful and faithful reestablishment of the original corner.

- # 8 Power pole S88E 104.42' spike in N. side
- # 12 Birch 10" S19E 36.47' spike in NE side
- # 13 Maple 6" S50W 56.98' spike in NW side
- # 14 Maple 5" N25E 52.4" spike in SE side

Corner is 500' + - East of Hamlin shores road in East -West power line

Signed by Sammy S. Barnett
Surveyor's Michigan License No. 16923

Date 9-27-96

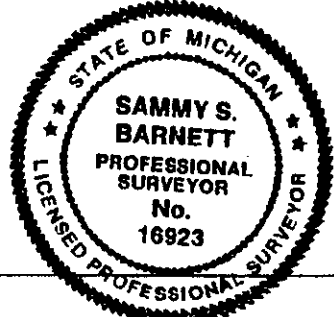

Peer Group Reviewed and Approved.
Date: 9-30-96
Kenneth L. Ross
Mason County Surveyor