

**SURVEY & REMONUMENTATION**


MAY 07 1987

COMMISSION

**LAND CORNER RECORDATION CERTIFICATE**  
Filing Requirement of Act 74, Mich. P.A. 1970

For corners in

Mason (County)	Located in:	Corner Code #
1. Public Land Survey	T 19N R 18W	M-05 ✓
	T 19M R 17W	A-05 Same corner
	T R	
	T R	
2. Property Controlling in Section	S T R	
	S T R	
3. Miscellaneous Property in Sec.	S T R	
	S T R	

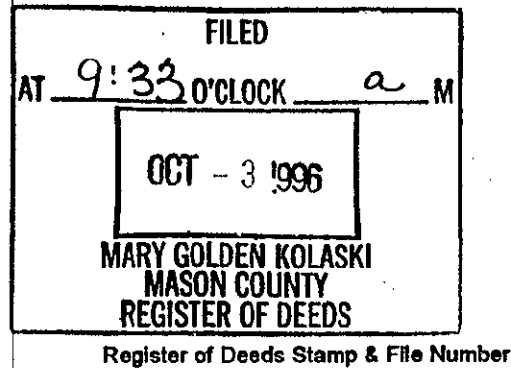

4. Lot No. \_\_\_\_\_, Recorded Plat \_\_\_\_\_  
5. Private Claims \_\_\_\_\_

I, Sammy S. Barnett, in a field survey on Sept, 19 96 do hereby state that under requirements of P.A. 74, Michigan P.A. of 1970, the corner points mentioned in lines 1 and 2 above were in conformance with regulations and rules therefore as required in the current manual of survey instructions of the United States Department of the Interior, Bureau of Land Management or by a decree of a Court of Law and/or that the corner points mentioned in lines 3, 4 and 5 above were in conformance with the rules of the Michigan Board of Land Surveyors or by a Decree of a Court of Law; established, re-established, monumented, recovered, found as expressed below:

	A	B	C	D	E	F	G	H	I	J	K	L	M
1													
2	6	5				4		3		2		1	
3													
4	7	8				9		10		11		12	
5													
6	10	17				16		15		14		13	
7													
8	19	20				21		22		23		24	
9													
10	30	29				28		27		26		25	
11													
12	31	32				33		34		35		36	
13													

NOTE: Not more than 2 corners, all in the same town and range, may be recorded on this certificate.

**A. Description of original monument and accessories and/or subsequent restoration:**

M-05 & A-05 Corner common to sections 12 & 13, T19N, R18W (Hamlin) & sections 7 & 18 T19N, R17W (Victory) same corner 1838 Mullett & Brookfield G.L.O.  
 Set post  
 #1 Hemlock 16" S46W 16 lks. (10.56')  
 #2 Hemlock 16" N13W 11 lks. (7.26')  
 1880 & 1887 J. Mitchell  
 No monument given  
 Old witness trees standing  
 1889 C.E. Mitchell found old witnesses

Undated M.C.R.C. found iron  
 N. side E-W rd. near C/1 Rd. S.  
 #3 Elm 8" S.W. 85.6'  
 #4 Fence C. N.E. 24.4'  
 #5 Power pole S.E. 48.5'  
 1959 office card  
 Ex. 1/2" bolt  
 #6 REA pole S.E. 48.4" (# 5)

#7 Elm 10" E.N.E. 115.0'  
 #8 Elm 8" W.S.W. 85.6' (# 3)  
 1973 L. Gerschbacher Act 74 L 1. P 230  
 3/4" iron bar was found  
 #9 Power pole S42E 48.80' (# 5 & 6)  
 #10 Fence cor. post N60W 53.40'

**B. Description of corner evidence found and/or method applied in restoring or reestablishing corner:**

M-05 & A-05 Corner common to sections 12 & 13, T19N, R18W (Hamlin) & sections 7 & 18 T19N, R17W (Victory) same corner  
 On Sept 12, I found 1/2" x 18" re-bar at intersection of roads N-S-E&W, I found no evidence to dispute this location. The condition of the recorded witnesses are:  
 # 1 Gone  
 # 2 Gone  
 # 3 Gone  
 # 4 Poor condition  
 # 5 Power pole SE 48.5'  
 # 6 Same as # 5  
 # 7 Gone  
 # 8 Gone


# 9 Same as # 5 & 6  
 # 10 Fence cor. post N60W 53.40'  
 # 11 Same as # 5, 6 & 9  
 # 12 Gone  
 # 13 "No outlet sign N11E 49.79"  
 # 14 Gone  
 # 15 Stop sign S26E 57.02'  
 # 16 Stop sign N21W 60.59'

**C. Description of monument for corner and accessories established to perpetuate locating the position of the corner:**

M-05 & A-05 Corner common to sections 12 & 13, T19N, R18W (Hamlin) & sections 7 & 18 T19N, R17W (Victory) same corner  
 I replaced the 1/2" re-bar, in the exact location, with a Standard Mason County Monument and accepted this location as a careful and faithful reestablishment of the original corner.  
 # 5 Power pole S 40E 48.65' spike in SW side  
 # 16 Stop sign N21W 60.59'  
 # 17 Triple Ash 9"-9" & 12" S12E 96.30' spike in SW side  
 # 18 Apple 8" S17W 91.05' spike in SE side

Signed by Sammy S. Barnett  
 Surveyor's Michigan License No. 16923

Date 9-28-96

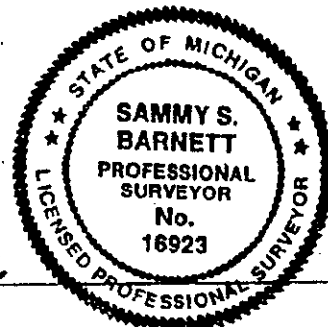

Peer Group Reviewed and Approved  
 Date: 9-30-96  
Kenneth L. Ross  
 Mason County Surveyor