

SURVEY & REMONUMENTATION


MAR 16 1998

LAND CORNER RECORDATION CERTIFICATE
Filing Requirement of Act 74, Mich. P.A. 1970

SECTION

For corners in

<u>MASON</u> (County)	Located In:	Corner Code #
1. Public Land Survey	T 19N R 18W	L-13
	T R	
	T R	
	T R	
	T R	<i>Sec. 2</i>
2. Property Controlling in Section	S T R	
	S T R	
3. Miscellaneous Property in Sec.	S T R	
	S T R	

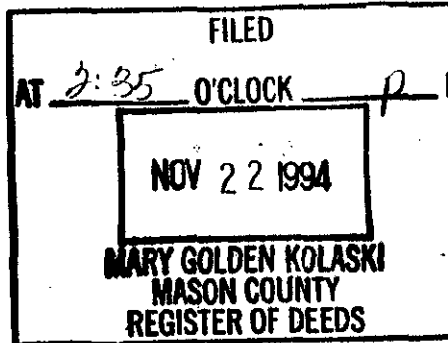

Register of Deeds Stamp & File Number

4. Lot No. _____, Recorded Plat _____
5. Private Claims _____

	A	B	C	D	E	F	G	H	I	J	K	L	N
2	6		5		4		3		2		1		
3													
4	7		8		9		10		11		12		
5													
6	18		17		16		15		14		13		
7													
8	19		20		21		22		23		24		
9													
10	30		29		28		27		26		25		
11													
12	31		32		33		34		35		36		
13													

I, Theodore H. Weinert, in a field survey on OCTOBER, 1994, do hereby certify that under requirements of P.A. 74, Michigan P.A. of 1970, the corner points mentioned in lines 1 and 2 above were in conformance with regulations and rules therefore as required in the current manual of survey instructions of the United States Department of the Interior, Bureau of Land Management or by a decree of a Court of Law and/or that the corner points mentioned in lines 3, 4 and 5 above were in conformance with the rules of the Michigan Board of Land Surveyors or by a Decree of a Court of Law; established, re-established, monumented, re-monumented, recovered, found as expressed below:

NOTE: Not more than 4 corners, all in the same town and range, may be recorded on this certificate.

A. Description of original monument and accessories and/or subsequent restoration:


L-13 1/4 Corner, Secs. 36
G.L.O. Notes Set Post
July, 1838, Sylvester Sibley
1 chain West of stream
6" Maple N 66 W 13 lks
9" Maple S 37 E 21 lks

B. Description of corner evidence found and/or method applied in restoring or reestablishing corner:

L-13 1/4 Corner, Secs. 36
Found 3/8" X 18" iron rebar pointed on end
4.58' West of N 1/4 corner Section 1, T18N, R18W.
Corner was 66.00' West of stream as called for in
G.L.O. Notes
This corner location is accepted as a careful and faithful perpetuation of the original corner.

C. Description of monument for corner and accessories established to perpetuate locating the position of the corner:

L-13 1/4 Corner, Secs. 36
Set 5/8" X 36" rebar with standard 2 1/2" cap stamped "Mason County Remonumentation".
Dbl. 8" & 12" Maple N 64 W 52.34'
8" Maple N 70 E 51.70'
12" Maple S 45 E 33.70'
18" Maple S 35 W 20.55'
On CL Decker Road
N 1/4 Corner Section 1, T18N, R18W, East 4.58'

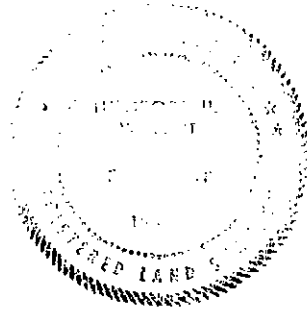

Peer Group Reviewed and Approved
Date: 11/16/94
Kenneth L. Ross
Mason County Surveyor

Signed by Theodore H. Weinert

Date 11/16/94

Surveyor's Michigan License No. 1964

Peer Group Reviewed and Approved
Date: 11-16-94
Kenneth L. Ross
Mason County Surveyor