

SURVEY & REMONUMENTATION

SEP 30 1993

COMMISSION

LAND CORNER RECORDATION CERTIFICATE Filing Requirement of Act 74, Mich. P.A. 1970

For corners in


MASON
(County)

Located In:

Corner Code #

1. Public Land Survey T 19N R 15W
2. Property Controlling in Section S T R
3. Miscellaneous Property in Sec. S T R
4. Lot No. , Recorded Plat
5. Private Claims

B/C I

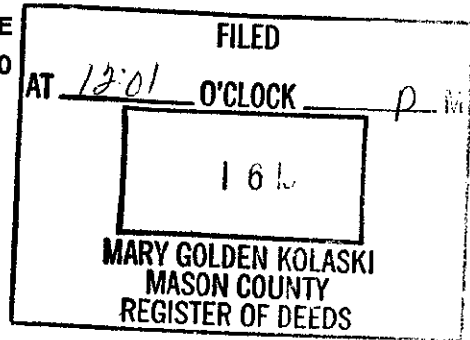

Register of Deeds Stamp & File Number

	A	B	C	D	E	F	G	H	I	J	K	L	M
2	6	5	4	3	2	1							
3													
4	7	8	9	10	11	12							
5													
6	18	17	16	15	14	13							
7													
8	19	20	21	22	23	24							
9													
10	30	29	28	27	26	25							
11													
12	31	32	33	34	35	36							
13													

I, Sammy S. Barnett, in a field survey on AUGUST, 19 93, do hereby certify that under requirements of P.A. 74, Michigan P.A. of 1970, the corner points mentioned in lines 1 and 2 above were in conformance with regulations and rules therefore as required in the current manual of survey instructions of the United States Department of the Interior, Bureau of Land Management or by a decree of a Court of Law and/or that the corner points mentioned in lines 3, 4 and 5 above were in conformance with the rules of the Michigan Board of Land Surveyors or by a Decree of a Court of Law; established, re-established, monumented, re-monumented, recovered, found as expressed below:

NOTE: Not more than 4 corners, all in the same town and range, may be recorded on this certificate.

A. Description of original monument and accessories and/or subsequent restoration:

B-1 1/4 corner, Sec. 6

John Brink surveyed South Township Boundary line of Township to the North (T20N, R15W), Set South 1/4 cor. for Sec., 31, T20N, R15W), Did not set North 1/4 cor. Sec. 6 T19N, R15W, Being a computed location of 331ks., from G. L. O. Notes, being East of cor., to the North.

C-1 Section corner, Sec's., 5 & 6 on Township line

Post placed by John Brink in Sudivision survey May, 1838
S 34° W 231ks. (15.18') 10" Beech
S 28° E 231ks. (15.18') 12" Pine

B. Description of corner evidence found and/or method applied in restoring or reestablishing corner:

B-1 1/4 corner, North 1/4 cor., Sec. 6

C. E. Mitchell established new B. T.s in 1918 Subdivision survey.
S 86 1/2° E 651ks. (42.90') 10" White Pine
S 32° E 731ks. (47.52') Pine Stump
Robert Griffin found Mitchells B. T.s & Stake replaced with 1/2" X 36" re-rod, November, 1974
S 81° E 43.31' N. Pine 21"
S 16° W 28.81' Maple 7"
S 74° W 12.47' Maple 8"

C-1 Section corner, Sec's., 5 & 6 on Township line

C. E. Mitchell established new B. T.s in 1918 Subdivision survey.
S 231/2° W 811ks. (53.46') Pine Stump 24"
N 77° W 1101ks. (72.60') Pine Stump 22"
G. Dyksterhouse(USFS) found C.F. Harden(USFS)Post 19.5 ft. West of Mound of Stones, 1940.
(No References)

C. Description of monument for corner and accessories established to perpetuate locating the position of the corner:

B-1 1/4 corner, North 1/4 cor., Sec. 6

Found 1/2" X 36" re-rod, replaced with 5/8" X 36" re-rod with 2 1/2" alum. cap, and is accepted as a careful and faithful reestablishment of the position of the original corner.
N 35° E 20.71' 9" White Oak
S 63° E 25.87' 8" Red Oak
S 12° W 28.82' 10" Black Ash
S 74° W 12.29' 13" Red Maple

C-1 Section corner, Sec's., 5 & 6 on Township line

Found 1 1/4" Iron Pipe, replaced with 5/8" X 36" re-rod with 2 1/2" alum. cap, and is accepted as a careful and faithful reestablishment of the position of the original corner.
N 74° W 1.53' 4" Sugar Maple
N 06° E 166.74' 10" White Birch
N 73° E 98.07' 7" Red Pine
S 65° E 142.09' 8" Red Pine

Signed by Sammy S. Barnett

Date 9/7/93

Surveyor's Michigan License No. 16923

Peer Group Reviewed and Approved

Date: 9-7-93
Kenneth L. Ross
Mason County Surveyor

FORM APPROVED BY MICHIGAN STATE BOARD OF LAND SURVEYORS, JAN. 28, 1971
REVISED MAY 14, 1975
REVISED JAN., 1983