

FEB 08 2000


SECTION

LAND CORNER RECORDATION CERTIFICATE

Filing Requirement of Act 74, Mich. P.A. 1970

For corners In: Located In: Corner Code #
Mason County

- 1. Public Land Survey T 19N R 15W B-13
T _____ R _____
T _____ R _____
T _____ R _____
- 2. Property Controlling S _____ T _____ R _____
in Section S _____ T _____ R _____
- 3. Miscellaneous S _____ T _____ R _____
- Property in Sec. S _____ T _____ R _____

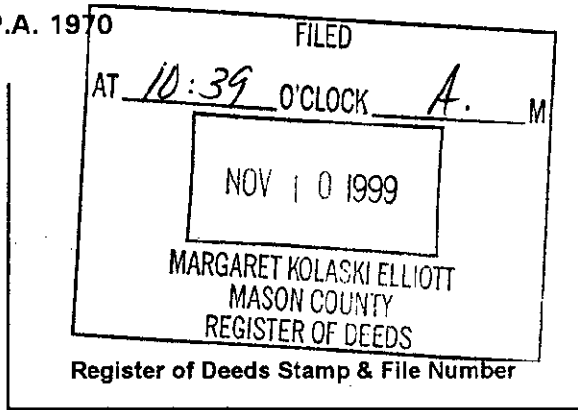

- 4. Lot No. _____, Recorded Plat _____
- 5. Private Claims _____

	A	B	C	D	E	F	G	H	I	J	K	L	M
1													
2	6	5	4	3	2	1							
3													
4	7	8	9	10	11	12							
5													
6	18	17	16	15	14	13							
7													
8	19	20	21	22	23	24							
9													
10	30	29	28	27	26	25							
11													
12	31	32	33	34	35	36							
13													

I, Kenneth L. Ross, in a field survey on October 15, 1999, Do hereby certify that under requirements of P.A. 74, Michigan P.A. of 1970, the corner points mentioned in lines 1 and 2 above were in conformance with regulations and rules therefore as required in the current manual of survey instructions of the United States Department of the Interior, Bureau of Land Management or by a decree of a Court of Law and/or that the corner points mentioned in lines 3, 4 and 5 above were in conformance with the rules of the Michigan Board of Land Surveyors or by a Decree of a Court of Law; established, re-established, monumented, re-monumented, recovered, found as expressed below:

NOTE: Not more than 4 corners, all in the same town and range, may be recorded on this certificate.

A. Description of original monument and accessories and/or subsequent restoration:

S ¼ Corner Section 31, T. 19N., R. 18W.,

GLO, Mullett and Brookfield, 1838

"Set quarter section post"

(1) Beech, 15", N6°W, 24 links (15.84')

(2) Beech, 18", N57°E, 53 links (34.98')

W.E. Metcalf, Book 1, page 235, 1891

"Established by Measurement" No Witnesses Given.

"Large Tall Stump, 2.12 chains (139.92') East of Stake on Line."

Distance West to A-13, T. 19N., R. 15W., 2571.36'

Distance East to C-13, T. 19N., R. 15W., 2651.88'

I found no other recorded documentation on this corner.

B. Description of corner evidence found and/or method applied in restoring or reestablishing corner:

S ¼ Corner Section 31, T. 19N., R. 18W.,

I could not locate this corner in the field. I then measured the distance from A-13, to C-13, (5205.01') and using the above described Metcalf Survey (5223.24') I prorated the distances to establish the position of this corner.

$$\frac{5205.01}{5223.24} \times 2651.88 = 2642.62'$$

C. Description of monument for corner and accessories established to perpetuate locating the position of the corner:

S ¼ Corner Section 31, T. 19N., R. 18W.,

I Set a 3" Harrison Cast Iron Monument Stamped "Mason County Monument" in the Center-line of Decker Road, 1.0' below the surface and on a straight line between Corners A-13 and C-13, 2642.62' West of Corner C-13 as prorated in (B) above and is accepted this location as a careful and faithful reestablishment of the position of the original corner.


(3) Corner B-1, T. 18N., R. 15W., Set 3" Harrison Cast Iron Monument, East, 36.30'

(4) Set 60d spike, North side of 24" Maple, N77°W, 96.47'

(5) Set 60d spike West side of P.P., S01°W, 41.23'

(6) Distance West to A-13, T. 19N., R. 15W., 2562.39'

(7) Distance East to C-13, T. 19N., R. 15W., 2642.62'

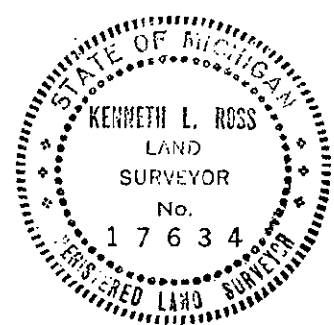

Signed by [Signature] Date Nov 4, 1999

Surveyor's Michigan License No. 17634

Approved by Peer Review Group on Nov 4, 1999
Kenneth L. Ross, County Representative [Signature]