

**SURVEY &
REMONUMENTATION**

SEP 30 1993

COMMISSION


LAND CORNER RECORDATION CERTIFICATE
Filing Requirement of Act 74, Mich. P.A. 1970



For corners in

MASON _____
(County)

Located in:

Corner Code #

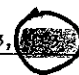- 1. Public Land Survey T 19N R 15W B-3, 
- T _____ R _____
- T _____ R _____
- T _____ R _____
- 2. Property Controlling S _____ T _____ R _____
in Section S _____ T _____ R _____
- 3. Miscellaneous S _____ T _____ R _____
Property in Sec. S _____ T _____ R _____
- 4. Lot No. _____, Recorded Plat _____
- 5. Private Claims _____

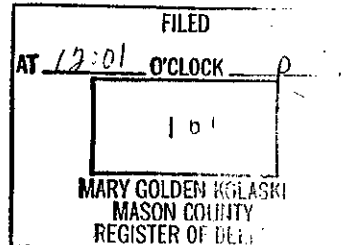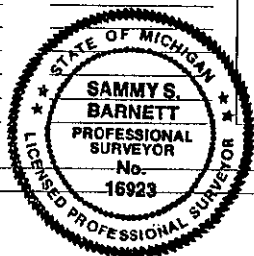

Register of Deeds Stamp & File Number

I, Sammy S. Barnett, in a field survey on AUGUST, 19 93 do hereby certify that under requirements of P.A. 74, Michigan P.A. of 1970, the corner points mentioned in lines 1 and 2 above were in conformance with regulations and rules therefore as required in the current manual of survey instructions of the United States Department of the Interior, Bureau of Land Management or by a decree of a Court of Law and/or that the corner points mentioned in lines 3, 4 and 5 above were in conformance with the rules of the Michigan Board of Land Surveyors or by a Decree of a Court of Law; established, re-established, monumented, re-monumented, recovered, found as expressed below:

NOTE: Not more than 4 corners, all in the same town and range, may be recorded on this certificate.

	A	B	C	D	E	F	G	H	I	J	K	L	M
2	6	5	4	3	2	1							
3	7	6	5	4	3	2	1						
4	8	7	6	5	4	3	2	1					
5	9	8	7	6	5	4	3	2	1				
6	10	9	8	7	6	5	4	3	2	1			
7	11	10	9	8	7	6	5	4	3	2	1		
8	12	11	10	9	8	7	6	5	4	3	2	1	
9	13	12	11	10	9	8	7	6	5	4	3	2	1
10	14	13	12	11	10	9	8	7	6	5	4	3	2
11	15	14	13	12	11	10	9	8	7	6	5	4	3
12	16	15	14	13	12	11	10	9	8	7	6	5	4
13	17	16	15	14	13	12	11	10	9	8	7	6	5

A. Description of original monument and accessories and/or subsequent restoration:

B-3 1/4 corner, Sec's., 6 & 7

C-3 Section corner, Sec's., 5, 6, 7 & 8

Post placed by Sylvester Sibley in Sub division survey, 1838.
N 67° W 40lks. (26.40') 20" Beech
S 57° E 30lks. (19.80') 8" Beech

Post placed by Sylvester Sibley in Subdivision survey in 1838.
S 43° E 10lks. (6.60') 12" Beech
N 33° W 13lks. (8.58') 10" Beech

C. E. Mitchell found old Stake & Stone by former Surveyor. (No References), April 1914.

C. E. Mitchell found old Stake placed by former surveyor 15 years earlier, Survey in April 1914. (No References)

B. Description of corner evidence found and/or method applied in restoring or reestablishing corner:

B-3 1/4 corner, Sec's., 6 & 7

C-3 Section corner, Sec's., 5, 6, 7 & 8

C. E. Mitchell found Iron Pipe in Subdivision survey in 1918. (No References)

C. F. Harden (U.S.F.S.) found Wood Stake
S 10 1/2° W 11lks. (7.26') 16" Red Pine
N 29 1/4° W 24lks. (15.84') 28" White Pine

Sam Barnett found 1 1/2" Iron Pipe at center line of Budzynski rd. and at Fence corner to the West in 1987 survey.

Sam Barnett found Wood Stake at U.S.F.S. Post, replaced with 1/2" Re-rod, with R.L.S. cap, October, 1987
N 15° W 7.09' 8" Poplar
S 69° W 12.80' 8" Poplar

C. F. Harden (USFS) found Iron Pipe, buried in Road Fence corner post West 29lks. (19.14')

Ken Stephens found Well Point in 1962, P. C. A. notes. (No References)

C. Description of monument for corner and accessories established to perpetuate locating the position of the corner:

B-3 1/4 corner, Sec's., 6 & 7

C-3 Section corner, Sec's., 5, 6, 7 & 8

Found 1 1/2" Iron Pipe, drove 5/8" X 24" re-rod with alum. cap, into existing pipe, and is accepted as the best available evidence of the position of the original corner.

Found 1/2" Re-rod, replaced with 5/8" X 24" RE-rod with alum. cap, and is accepted as a careful and faithful reestablishment of the position of the original corner.

N 67° E 52.78' 5" Sugar Maple
S 38° E 18.20' 6" Basswood
S 46° W 46.88' 4" Apple
N 45° W 45.00' Capped 1/2" re-rod

S 23° W 21.75' 3" White Oak
N 17° E 31.57' 5" Sugar Maple
S 24° E 16.30' 4" Red Oak
S 78° E 17.31' Tw. Red Maple 20", 14"

Signed by Sammy S. Barnett Date 9/9/93

Surveyor's Michigan License No. 16923

Peer Group Reviewed and Approved

Date: 9-9-93

Kenneth L. Press
Mason County Surveyor

FORM APPROVED BY MICHIGAN STATE BOARD OF LAND SURVEYORS, JAN. 28, 1971
REVISED MAY 14, 1975
REVISED JAN., 1983

LIBER

3 PAGE 103