

FEB 08 2000


SECTION

LAND CORNER RECORDATION CERTIFICATE

Filing Requirement of Act 74, Mich. P.A. 1970

For corners In: Located In: Corner Code #
Mason County

- 1. Public Land Survey T 19N R 15W c-13
T R
T R
T R
- 2. Property Controlling in Section S T R
S T R
- 3. Miscellaneous S T R
- Property in Sec. S T R

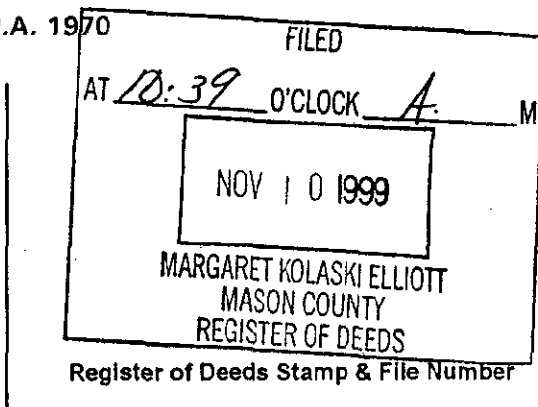

- 4. Lot No. _____, Recorded Plat _____
- 5. Private Claims _____

I, Kenneth L. Ross, in a field survey on October 16, 1999, Do hereby certify that under requirements of P.A. 74, Michigan P.A. of 1970, the corner points mentioned in lines 1 and 2 above were in conformance with regulations and rules therefore as required in the current manual of survey instructions of the United States Department of the Interior, Bureau of Land Management or by a decree of a Court of Law and/or that the corner points mentioned in lines 3, 4 and 5 above were in conformance with the rules of the Michigan Board of Land Surveyors or by a Decree of a Court of Law; established, re-established, monumented, re-monumented, recovered, found as expressed below.

NOTE: Not more than 4 corners, all in the same town and range, may be recorded on this certificate.

A. Description of original monument and accessories and/or subsequent restoration:

Corner Common to Sections 31 and 32, T.19N., R.15W.,

GLO Mullett and Brookfield, 1838
Set post to sections 31 and 32
(1) Tamarack, 6", N66°W, 11 links, (7.26')
(2) Tamarack, 7", N4°E, 14 links, (9.24')

R.O. Towns, 1897, Book 1, page 307
Does not state what he found or set
No Witnesses given.
Distance East to D-13, 2610.96
Distance North to C-12, 2583.24'

W.E. Metcalf, Book 1, page 235, 1891,
*Set this corner 55 links (36.30') west of corner common to Sections 5 & 6, T.18N., R.15W., set by J. Mitchell according to testimony
No Witnesses given.
Distance West to B-13, 2651.88'
Distance North to C-12, 2587.20'

I found no other recorded documentation for this corner.

B. Description of corner evidence found and/or method applied in restoring or reestablishing corner:

Corner Common to Sections 31 and 32, T.19N., R.15W.,

I found Corner C-1, T.18N., R.15W., and set Corner C-13, 36.30 feet West as stated by Metcalf in (A) above and on a straight line between corners C-1, T.18N., R.15W., and B-13 T.19N., R.15W., Note: corner B-13 is on a straight line between Corner C-1 T.18N., R.15W., and A-13 T.19N., R.15W.,


C. Description of monument for corner and accessories established to perpetuate locating the position of the corner:

Corner Common to Sections 31 and 32, T.19N., R.15W.,

I set a 3" Harrison Cast Iron Monument stamped "Mason County Monument" in the center-line of Decker Road, 1.0' below the surface and accepted this location as the best available evidence of the position of the corner.

- (3) Corner C-1, T.18N., R.15W., Existing, 3" Harrison Cast Iron Monument, East, 36.30'
 - (4) Center Sign Post, S63°E, 63.00'
 - (5) Center Sign Post, N35°E, 30.45'
 - (6) Existing 60d spike SE side of Telephone Guard Post, N67°E, 60.78'
 - (7) Distance West to Corner B-13, T.19N., R.15W., 2642.80'
- Center-line of Larsen Road, East 36'

LIBER 4 PAGE 30

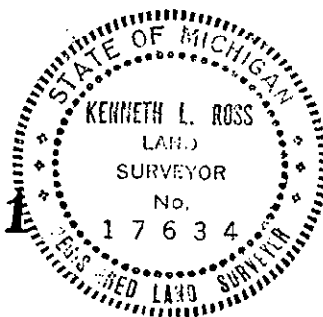

Signed by [Signature] Date Nov 4, 1999

Surveyor's Michigan License No. 17634

Approved by Peer Review Group on Nov 4, 1999
Kenneth L. Ross, County Representative [Signature]