


FEB 08 2000

SECTION

LAND CORNER RECORDATION CERTIFICATE

Filing Requirement of Act 74, Mich. P.A. 1970

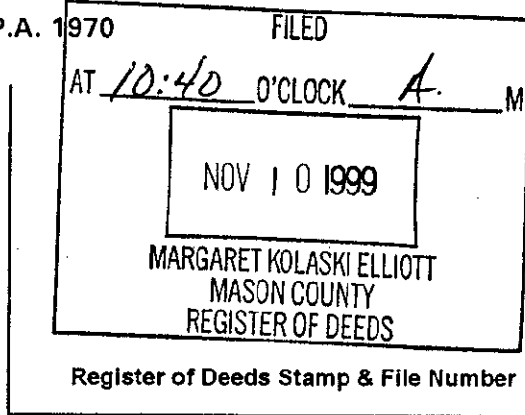

For corners In: Located In: Corner Code #  
Mason County

- 1. Public Land Survey T 19N R 15W D-13
- 2. Property Controlling in Section S      T      R
- 3. Miscellaneous S      T      R
- Property in Sec. S      T      R

- 4. Lot No. \_\_\_\_\_, Recorded Plat \_\_\_\_\_
- 5. Private Claims \_\_\_\_\_

I, Kenneth L. Ross, in a field survey on June 5, 1999, Do hereby certify that under requirements of P.A. 74, Michigan P.A. of 1970, the corner points mentioned in lines 1 and 2 above were in conformance with regulations and rules therefore as required in the current manual of survey instructions of the United States Department of the Interior, Bureau of Land Management or by a decree of a Court of Law and/or that the corner points mentioned in lines 3, 4 and 5 above were in conformance with the rules of the Michigan Board of Land Surveyors or by a Decree of a Court of Law; established, re-established, monumented, re-monumented, recovered, found as expressed below:

NOTE: Not more than 4 corners, all in the same town and range, may be recorded on this certificate.

A. Description of original monument and accessories and/or subsequent restoration:

S 1/4 Corner Section 32, T.19N., R.15W.,

- GLO Mullett and Brookfield, 1838
- Set quarter section post
- (1) Hemlock, 9", N21°E, 14 links, (9.24')
- (2) Beech, 9", N82°W, 21 links (13.86')

- K.L. Ross, Act 132, 1973
- "Set 1/2" re-bar, by occupation"
- (3) Post, S02°W, 28.86'
- (4) P.P. S45°W, 36.01'
- Distance East to E-13, 2674.00'

R.O. Towns, Book 1, page 307, No comment  
On Corner, No Witnesses Given.  
Distance East to E-13, 2640.00'  
Distance West to C-13, 2610.96'

During the research of this corner I could not locate any other data.

B. Description of corner evidence found and/or method applied in restoring or reestablishing corner:

S 1/4 Corner Section 32, T.19N., R.15W.,

Found 5/8" X 18" Bolt as riser to 1/2" re-bar as described by K.L. Ross above inside a Monument Box. Witnesses (1) through (4) have been destroyed. I found no other evidence to dispute the location of this corner.

C. Description of monument for corner and accessories established to perpetuate locating the position of the corner:

S 1/4 Corner Section 32, T.19N., R.15W.,

I replaced the 5/8" X 18" Bolt and 1/2" re-bar in the exact location with a Standard 3" Cast Iron Harrison Monument stamped "Mason County Monument" inside the Monument Box, 2.5' South of the center-line of Decker Road and in the center-line of Morse Road to the North, 6' below the surface. This corner accepted as the best available evidence of the re-establishment of the position of the original corner.

- (5) Set 60d Spike West Side P.P. S34°E, 47.80'
- (6) Set 60d Spike, SE side of 18" Elm, N55°E, 58.04'
- (7) Center of Steel Fence post S66°E, 78.10'
- (8) Center of East Post of Arrow Road Sign, S5°W, 25.30'
- (9) Corner D-1, T.18N., R.15W., Harrison cast iron monument, East, 35.04'
- Center-line of Decker Road, North 2.5; on the Center-line of Morse Road to the North.

	A	B	C	D	E	F	G	H	I	J	K	L	M
1													
2	6	5	4	3	2	1							
3													
4	7	8	9	10	11	12							
5													
6	18	17	16	15	14	13							
7													
8	19	20	21	22	23	24							
9													
10	30	29	28	27	26	25							
11													
12	31	32	33	34	35	36							
13													

LIBER 4 PAGE 302

Signed by [Signature] Date Nov. 4, 1999

Surveyor's Michigan License No. 17634

Approved by Peer Review Group on Nov. 4, 1999  
Kenneth L. Ross, County Representative [Signature]

