

MAR 08 1994

COMMISSIONER

LAND CORNER RECORDATION CERTIFICATE  
Filing Requirement of Act 74, Mich. P.A. 1970

For corners in

MASON  
(County)

Located In:

Corner Code: //

- 1. Public Land Survey T 19N R 15W  
T 19N R 15W  
T R  
T R
- 2. Property Controlling S T R  
in Section S T R
- 3. Miscellaneous S T R  
Property in Sec. S T R



FILED  
AT 10.45 O'CLOCK 9 M  
NOV 1 1993  
MARY GOLDEN KOLASKI  
MASON COUNTY  
REGISTER OF DEEDS  
Register of Deeds Stamp & File Number

- 4. Lot No. \_\_\_\_\_, Recorded Plat \_\_\_\_\_
- 5. Private Claims \_\_\_\_\_

	A	B	C	D	E	F	G	H	I	J	K	L	M
2	6	5	4	3	2	1							
3													
4	7	8	9	10	11	12							
5													
6	10	17	16	15	14	13							
7													
8	19	20	21	22	23	24							
9													
10	30	29	28	27	26	25							
11													
12	31	32	33	34	35	36							
13													

I, John Schulke, in a field survey on Sept. 23 & 24, 1993, do hereby certify that under requirements of P.A. 74, Michigan P.A. of 1970, the corner points mentioned in lines 1 and 2 above were in conformance with regulations and rules therefore as required in the current manual of survey instructions of the United States Department of the Interior, Bureau of Land Management or by a decree of a Court of Law and/or that the corner points mentioned in lines 3, 4 and 5 above were in conformance with the rules of the Michigan Board of Land Surveyors or by a Decree of a Court of Law; established, re-established, monumented, re-monumented, recovered, found as expressed below:

NOTE: Not more than 4 corners, all in the same town and range, may be recorded on this certificate.

A Description of original monument and accessories and/or subsequent restoration:

G-3 Original survey established in 1838 by Sibley. A 1 1/2" dia. Tamarack for corner tree. No corner references.

G-4 Original survey established in 1838 by Sibley. Set a wooden post with the following references: Bearing trees: Maple 10" S64°W 8 lks. Hemlock 10" N82°E 21 lks.


In 1980, Griffin accepted Ross computed corner (see Corner Book, corners H-3 & G-4 in book 2 page 86 in the Mason County Register of Deed's Office).

In 1980, Griffin found 1/2" iron rebar set by Ross. Replaced 1/2" dia. rebar with a 1 1/2" dia. X 60" concrete filled iron pipe with a brass cap stamped to identify the corner (see Corner Book 2, page 86 in the Mason County Register of Deed's Office).

B Description of corner evidence found and/or method applied in restoring or reestablishing corner:

G-3 No evidence found, restored corner by double proportionate measurement. The following bearing and distance to nearest corners:  
West 1/4 corner of Section 3 N0°18'59"E 2653.61 ft.  
South 1/4 corner of Sec. 3 S87°47'03"E 2631.32 ft.  
SW corner of Section 10 S0°05'02"W 5307.14 ft.  
Meander corner Sec's 4 & 9 N89°00'23"W 4540.41 ft.

G-4 Found iron pipe as described above. Position not accepted due to changes in controlling corners. The following bearing and distance to nearest corners:  
NW corner of Section 10 N0°05'02"E 2653.57 ft.  
SW corner of Section 10 S0°05'02"W 2653.57 ft.

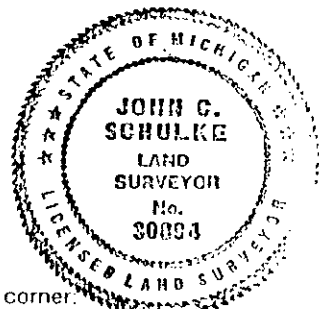

C Description of monument for corner and accessories established to perpetuate locating the position of the corner:

G-3 In Sept. 1993, set 2 1/2" dia. X 30" steel pipe monument with a brass cap stamped to identify the corner. The reference trees are blazed and scribed as following:  
Red Maple 6" N33°W 23.01 ft.  
Red Maple 4" N85°W 20.85 ft.  
Twin Red Maple 9" N17°E 22.99 ft.  
Red Maple 4" S66°E 27.67 ft.  
Fiberglass sign post NE 0.5 ft.

G-4 In Sept. 1993, moved iron pipe to new position. Previous position S8°04'E 26.60 feet. Stamped the year, my RLS# and initials on monument. The reference trees are blazed and scribed as following:  
Blk. Cherry 6" N78°W 36.01 ft.  
Red Oak 8" S19°E 40.41 ft.  
Red Maple 6" N02°E 49.29 ft.  
Red Maple 8" N69°E 84.55 ft.  
Pine stump S08°W 37.38 ft.  
Dying Jack Pine 6" S60°E 58.11 ft.  
(1980 blaze)  
Wood post NE 1.72 ft.

Signed by John C. Schulke Date Oct. 12, 1993

Surveyor's Michigan License No. RLS-30894

Reviewed and Approved  
Date: 10-12-93  
Kenneth L. Ross  
Mason County Surveyor

FORM APPROVED BY MICHIGAN STATE BOARD OF LAND SURVEYORS, JAN. 28, 1971  
REVISED MAY 14, 1975  
REVISED JAN. 1983

LIBER