

MAR 08 1994

COMMISSION

LAND CORNER RECORDATION CERTIFICATE

Filing Requirement of Act 74, Mich. P.A. 1970

For corners in

MASON

(County)

Located In:

Corner Code: *11*

1. Public Land Survey

T 19N R 15W

T 19N R 15W

T 19N R 15W

T R

S T R

S T R

S T R

S T R

G-1

(circled)

I-1

FILED

AT *10:43* O'CLOCK *9* M

NOV 9 1993

MARY GOLDEN KOLASKI
MASON COUNTY
REGISTER OF DEEDS

Register of Deeds Stamp & File Number

4 Lot No.

Recorded Plat

5. Private Claims

I, John Schulke, in a field survey on Oct., 22nd & 25th 1993 do hereby certify that under requirements of P.A. 74, Michigan P.A. of 1970, the corner points mentioned in lines 1 and 2 above were in conformance with regulations and rules therefore as required in the current manual of survey instructions of the United States Department of the Interior, Bureau of Land Management or by a decree of a Court of Law and/or that the corner points mentioned in lines 3, 4 and 5 above were in conformance with the rules of the Michigan Board of Land Surveyors or by a Decree of a Court of Law; established, re-established, monumented, re-monumented, recovered, found as expressed below:

NOTE: Not more than 4 corners, all in the same town and range, may be recorded on this certificate.

A Description of original monument and accessories and/or subsequent restoration:

G-1
In 1838, Sibley established 12" dia. Cedar tree as the corner. G-13 (Southwest corner of Section 34, T20N, R15W) is 17 lks. West of tree. No BT.

H-1
Not a government corner.

I-1
In 1838, Sibley established 9" dia. cedar tree as the corner. I-13 (Southeast corner of Section 34, T20N, R15W) is 29 lks. West of tree. No BT

In 1979, K. Ross found well point at the corner. The Southeast corner of Section 34 (T20N, R15W) West a distance of 18.87 ft. of I-1.


In 1983 R. Griffin, replaced well point with 5"X60" concrete monument with a brass cap stamped to identify the corner. Set Fiberglass post. CONTINUE ON BACK

I-1
Found monument as described by Griffin extending 1 ft. above ground (see corner certificate Liber 2, Page 161 in the Mason Co. Register of Deed's Office). Recovered the following corner references:

W Pine	11"	S43°W	72.90 ft.
W Pine	15"	S23°E	57.82 ft.
1 1/4" pipe		N89°34'W	18.92 ft.
Fiberglass post		West.	1.7 ft.

B Description of corner evidence found and/or method applied in restoring or reestablishing corner:
G-1
No GLO evidence found. Established G-13 (see 1993 corner certificate G-13, T20N, R15W).

H-1
Not previously established.

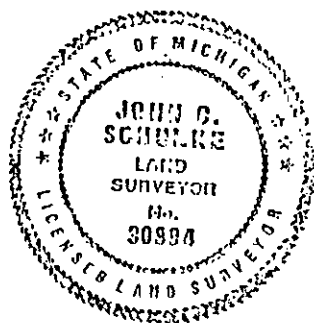

C Description of monument for corner and accessories established to perpetuate localizing the position of the corner:

G-1
Restored by measuring S89°54'E a distance of 11.22 ft. from restored I-13 (Southwest corner of Section 34, T20N, R15W) and on line with I-13 (Southeast corner of Section 34, T20N, R15W). Set 2 1/2" dia. X 30" iron pipe with a brass cap stamped to identify the corner. Set fiberglass post 1.0 ft. NE of the corner. The following corner references:

Oak	7"	S75°E	58.59 ft.
Pine	8"	N42°E	7.42 ft.
Pine	8"	S16°W	50.47 ft.
Maple	6"	S64°W	26.60 ft.

H-1
Established on the line between H-13 (North 1/4 corner of Section 34, T20N, R15W) and I-13 (Southeast corner of Section 34, T20N, R15W) and for distance at the midpoint between G-1 (Northwest corner of Section 3) and I-1 (Northeast corner of Section 3). Set 2 1/2" dia. X 30" iron pipe with a brass cap stamped to identify the corner. Set fiberglass post 1.5 ft. East of the corner. The South 1/4 of Section 34, T20N, R15W bears N89°54'W a distance of 15.07 ft.

I-1
The following new corner references:

Hemlock	14"	N81°E	15.28 ft.
Hemlock	16"	N22°W	45.43 ft.

Signed by *John G. Schulke*
Surveyor's Michigan License No. RLS-30894

Date *Nov 9, 1993*

Per Group Reviewed and Approved

FORM APPROVED BY MICHIGAN STATE BOARD OF LAND SURVEYORS, JAN 78, 1971
REVISED MAY 14, 1975
REVISED JAN 1, 1987

LIBER

3 PAGE

146

Date: *11-9-93*

Kenneth L. Ross
Mason County Surveyor

I-1 continued column "A"
 glass 1.6 ft. West of the corner. 1 1/4"
 iron pipe as the SE corner of Section 34, T20N
 R15W, is 18.91 West of the corner. The
 following bearing trees:
 W. Pine 11" S23°E 57.82 ft.
 W. Pine 9" S43°W 72.87 ft.

H-1 continued column "C"
 The following corner references:
 R Maple 13" N64°W 50.70 ft.
 W Oak 5" S89°W 43.84 ft.
 R Pine 9" S66°E 32.52 ft.
 clump of
 R Maple 7" N04°W 13.24 ft.