

FEB 08 2000

LAND CORNER RECORDATION CERTIFICATE

SECTION

Filing Requirement of Act 74, Mich. P.A. 1970

For corners In: Located In: Corner Code #
Mason County

- 1. Public Land Survey T 19N R 15W H-13
- 2. Property Controlling S _____ T _____ R _____
- in Section S _____ T _____ R _____
- 3. Miscellaneous S _____ T _____ R _____
- Property in Sec. S _____ T _____ R _____

- 4. Lot No. _____, Recorded Plat _____
- 5. Private Claims _____

FILED

AT 10:40 O'CLOCK A. M

NOV 10 1999

MARGARET KOLASKI ELLIOTT
MASON COUNTY
REGISTER OF DEEDS

Register of Deeds Stamp & File Number

	A	B	C	D	E	F	G	H	I	J	K	L	M
1													
2	6	5	4	3	2	1							
3													
4	7	8	9	10	11	12							
5													
6	18	17	16	15	14	13							
7													
8	19	20	21	22	23	24							
9													
10	30	29	28	27	26	25							
11													
12	31	32	33	34	35	36							
13													

I, Kenneth L. Ross, in a field survey on June 5, 1999, Do hereby certify that under requirements of P.A.74, Michigan P.A. of 1970, the corner points mentioned in lines 1 and 2 above were in conformance with regulations and rules therefore as required in the current manual of survey instructions of the United States Department of the Interior, Bureau of Land Management or by a decree of a Court of Law and/or that the corner points mentioned in lines 3, 4 and 5 above were in conformance with the rules of the Michigan Board of Land Surveyors or by a Decree of a Court of Law; established, re-established, monumented, re-monumented, recovered, found as expressed below.

NOTE: Not more than 4 corners, all in the same town and range, may be recorded on this certificate.

A. Description of original monument and accessories and/or subsequent restoration:
S ¼ Corner Section 34, T. 19N., R. 15W.,

- GLO Mullett and Brookfield, 1838
- "Set quarter section post"
- (1) Beech, 8", N20°W, 20 links (13.20')
- (2) Beech, 10", N73°E, 34 links, (22.44')

I Could not find any more recorded information on this Corner during the research.


B. Description of corner evidence found and/or method applied in restoring or reestablishing corner:
S ¼ Corner Section 34, T. 19N., R. 15W.,

I found a ½" X 18" pipe in the center-line of Decker Road, 8" below the surface of the road. Witnesses (1) and (2) have been destroyed. Center-line of a two track road to the North. I could not find any other evidence to dispute the location of this corner.

C. Description of monument for corner and accessories established to perpetuate locating the position of the corner:
S ¼ Corner Section 34, T. 19N., R. 15W.,

I replaced the ½" X 18" Pipe in the exact location with a Standard 3" Cast Iron Harrison Monument stamped "Mason County Monument" in the center-line of Decker Road, 1 foot below the surface. This corner accepted as the best available evidence of the re-establishment of the position of the original corner.

- (3) Existing 60d spike NE side 12" White Oak, N23°W, 27.81'
- (4) Existing 60d spike NE side 12" Sugar Maple, N63°W, 49.40'
- (5) Existing 60d spike SE side 15" Sugar Maple, S50°W, 74.14'
- (6) Set 60d spike NW side 12" Sugar Maple, S06°W, 53.74'
- (8) Corner H-1, T. 18N., R. 15W., 3" Harrison cast iron Monument, East 29.88'
- Center-line of Two Track Road to North.

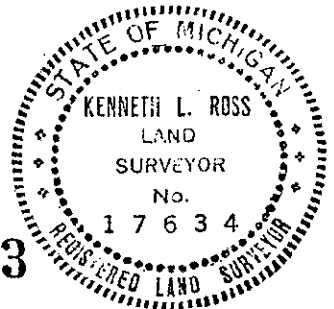

LIBER 4 PAGE 303

Signed by [Signature] Date Nov 4 1999

Surveyor's Michigan License No. 17634

Approved by Peer Review Group on Nov. 4 1999
Kenneth L. Ross, County Representative [Signature]