

SURVEY & REMONUMENTATION

MAR 16 1998

SECTION

LAND CORNER RECORDATION CERTIFICATE

Filing Requirement of Act 74, Mich. P.A. 1970

For corners in

MASON <small>(County)</small>	Located In:	Corner Code #:
1. Public Land Survey	T <u>19N</u> R <u>15W</u>	I-7
	T _____ R _____	
	T _____ R _____	
	T _____ R _____	<i>Seg. 2</i>
2. Property Controlling In Section	S _____ T _____ R _____	
	S _____ T _____ R _____	
3. Miscellaneous Property in Sec.	S _____ T _____ R _____	
	S _____ T _____ R _____	

FILED

AT 1:30 O'CLOCK P M

DEC 27 1994

MARY GOLDEN KOLASKI
MASON COUNTY
REGISTER OF DEEDS

Register of Deeds Stamp & File Number

4. Lot No. _____, Recorded Plat _____
5. Private Claims _____

	A	B	C	D	E	F	G	H	I	J	K	L	M
2	6	5	4	3	2	1							
3													
4	7	8	9	10	11	12							
5													
6	18	17	16	15	14	13							
7													
8	19	20	21	22	23	24							
9													
10	30	29	28	27	26	25							
11													
12	31	32	33	34	35	36							
13													


I, John C. Schulke, in a field survey on Dec. 12, 1994, do hereby certify that under requirements of P.A. 74, Michigan P.A. of 1970, the corner points mentioned in lines 1 and 2 above were in conformance with regulations and rules therefore as required in the current manual of survey instructions of the United States Department of the Interior, Bureau of Land Management or by a decree of a Court of Law and/or that the corner points mentioned in lines 3, 4 and 5 above were in conformance with the rules of the Michigan Board of Land Surveyors or by a Decree of a Court of Law; established, re-established, monumented, re-monumented, recovered, found as expressed below:

NOTE: Not more than 4 corners, all in the same town and range, may be recorded on this certificate.

- A. Description of original monument and accessories and/or subsequent restoration:
- In 1838, original survey established by Sibley Set a wood post (392 ft. North of MC) with the following corner references:
 Beech 8" N21°E 26 lks.
 Beech 8" N71°W 25 lks.
 Note: 74.06 chains leave lake on North side, two BT for MC
 80.00 chains Set post with beech trees as references (see above).
- In 1914, C.E. Mitchell identified NW corner by fence corners and road North. A fill of the corner about 5 ft. and frozen ground prevented digging for stake (see Book 2, Pages 190 & 191 in MC Court House).
- In 1964, MC Road Comm. indicated 1 1/2" iron pipe with the following corner ties: 34" Elm NE 56.5 ft.
 PP SW 124.7 ft.
 White painted fence post 29.1 ft.
 Cluster of 3 maples NW 32.4 ft.
- In 1970, MC Road Comm. indicated the following corner ties:
 (tag & nail) 4" T Apple 29.11 ft.
 6" Oak NE 65.88 ft.
- In 1965, Ray-Paul Subdivision shows an 1" iron pipe. No references. Stephens shows 295 ft. South to the Lake shore.
- In 1989, G. Bonnie found 1/2" rerod (see LCRC Liber 3, page 5) with the following corner ties:
 10" Oak S50°W 79.24 ft.
 1 ft. ± South of road center line
 2648.40 ft. West of South 1/4 corner.

B. Description of corner evidence found and/or method applied in restoring or reestablishing corner:

Found iron under a iron pin 2 ft. ± South of center line of road in area of road fill. GLO record to Lake is 97 ft. short based on Ray-Paul Subdivision.
 Existing West 1/4 corner of Section 23 S0°20'29"E 2698.13 ft.
 Existing North 1/4 corner of Section 23 S87°32'56"E 2638.79 ft.

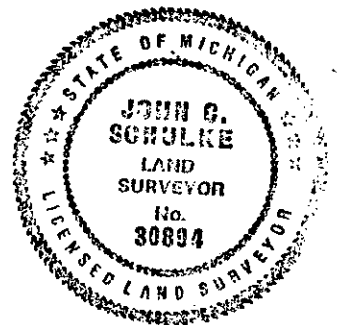

C. Description of monument for corner and accessories established to perpetuate locating the position of the corner:
 Accepted iron as the best available evidence of corner location and replaced it with 5/8" X3' rebar with an aluminum County cap in monument box stamped to identify the corner. The cap is 2 inches below the surface of the road. The following corner references:

- | | | | |
|----|-----------------|-------|-----------|
| 5" | W. Pine | N13°W | 80.20 ft. |
| 6" | W. Pine | N09°E | 56.96 ft. |
| | Power pole | N27°E | 38.25 ft. |
| 4" | W. Pine | S51°W | 54.40 ft. |
| | Rail Guard post | S31°E | 21.48 ft. |

Peer Group Reviewed and Approved
 Date: Feb 23 1995
 Kenneth L. Ross

Signed by John C. Schulke Date Dec 5, 1994
 Surveyor's Michigan License No. 30894

Peer Group Reviewed and Approved
 Date: 12-5-94 Date: 12-27-94
 Kenneth L. Ross
 Mason County Surveyor