

SURVEY & REMONUMENTATION


APR 28 1995

COMMISSION

LAND CORNER RECORDATION CERTIFICATE
Filing Requirement of Act 74, Mich. P.A. 1970

For corners in

MASON <small>(County)</small>	Located In:	Corner Code: #
1. Public Land Survey	T 19N R 15W	I-9
	T _____ R _____	_____
	T _____ R _____	_____
	T _____ R _____	_____
2. Property Controlling in Section	S _____ T _____ R _____	<i>Sec. 1</i>
	S _____ T _____ R _____	
3. Miscellaneous Property in Sec.	S _____ T _____ R _____	_____
	S _____ T _____ R _____	_____
4. Lot No. _____, Recorded Plat _____		
5. Private Claims _____		

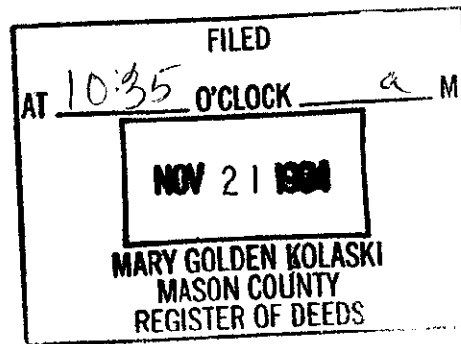

Register of Deeds Stamp & File Number

	A	B	C	D	E	F	G	H	I	J	K	L	M
2	6	5	4	3	2	1							
3													
4	7	8	9	10	11	12							
5													
6	18	17	16	15	14	13							
7													
8	19	20	21	22	23	24							
9													
10	30	29	28	27	26	25							
11													
12	31	32	33	34	35	36							
13													

I, John Schulke, in a field survey on Nov. 3, 1994, do hereby certify that under requirements of P.A. 74, Michigan P.A. of 1970, the corner points mentioned in lines 1 and 2 above were in conformance with regulations and rules therefore as required in the current manual of survey instructions of the United States Department of the Interior, Bureau of Land Management or by a decree of a Court of Law and/or that the corner points mentioned in lines 3, 4 and 5 above were in conformance with the rules of the Michigan Board of Land Surveyors or by a Decree of a Court of Law; established, re-established, monumented, re-monumented, recovered, found as expressed below:

NOTE: Not more than 4 corners, all in the same town and range, may be recorded on this certificate.

A. Description of original monument and accessories and/or subsequent restoration:
Original survey established in 1838 by Sibley.

Set a wooden post with the following references:

1. Beech 8" N03°E 41 lks.
2. Beech 6" S10°W 22 lks.

In 1914, CE Mitchill (see Book 2, Pages 190 & 191) Southwest corner identified by stake and resident land owner and East, West, North, South roads.
No references:

Unknown date, Mason Co. Rd. Comm. indicated 1" iron stake with the following corner references:

3. Norway pine 12" NW 61 ft.
4. Poplar 12" NE 60 ft.

B. Description of corner evidence found and/or method applied in restoring or reestablishing corner:

Recovered 3/4" iron pipe (6 in. below the surface of the road).
References #3 and 10 are the same-recovered
References #7-recovered
References # 6 and 9-changed
All other references are gone.

5. Norway 12" SE 66 ft.
6. Fence corner SW 40.9 ft.


Barnett Survey records indicate with the following corner references:

7. Power pole NW 52.2 ft.
8. Fence corner NE 35.5 ft.
9. Fence corner SW 43.6 ft.
10. Norway pine NW 61.57 ft.

In 1984, D. Dunlap indicated found 1/2" iron pipe (see corner certificate Liber 2, Page 217) with the following corner references:

11. Oak 16" S85°30'E 13.26 ft.

CONTINUE ON BACK

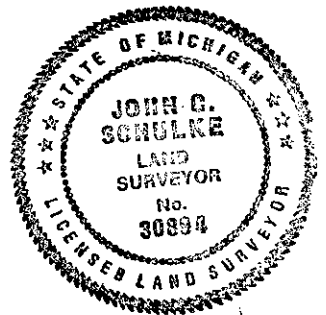

C. Description of monument for corner and accessories established to perpetuate locating the position of the corner:

Replaced 3/4" iron pipe with 5/8"X2' rerod with an aluminum cap monument stamped to identify the corner. The monument is 1 ft. below the surface of the road (Cross roads of Dewey & Taylor). The following corner references:

- | | | | |
|-------------|-----|-------|----------------------|
| R Pine | 25" | N69°W | 61.57 ft. |
| corner post | | S51°W | 47.97 ft. |
| Power pole | | N35°W | 52.57 ft. |
| R pine | 12" | S25°E | 63.95 ft. (scribed) |
| R Maple | 8" | S74°W | 103.45 ft. (scribed) |

(NOTE: Corner is accepted as the best evidence of the perpetuated location of the original corner).

Signed by John C Schulke Date Nov 11, 1994
Surveyor's Michigan License No. PLS-30894

Date: 11-16-94
Kenneth L. Ross
Mason County Surveyor

Continued column "A": I-9

12.	Maple	6"	N24°E	28.40 ft.
13.	Oak	6"	N24°W	37.39 ft.
14.	R Pine	18"	N25°E	61.08 ft.
7.	Power pole		N50°E	52.73 ft.