


MAR 16 1998

SECTION

LAND CORNER RECORDATION CERTIFICATE
Filing Requirement of Act 74, Mich. P.A. 1970

For corners in

<u>MASON</u> (County)	Located In:	Corner Code :#
1. Public Land Survey	T 19N R 15W	I-9
	T _____ R _____	
	T _____ R _____	
	T _____ R _____	
2. Property Controlling In Section	S _____ T _____ R _____	<i>Seg-2</i>
	S _____ T _____ R _____	
	S _____ T _____ R _____	
3. Miscellaneous Property In Sec.	S _____ T _____ R _____	

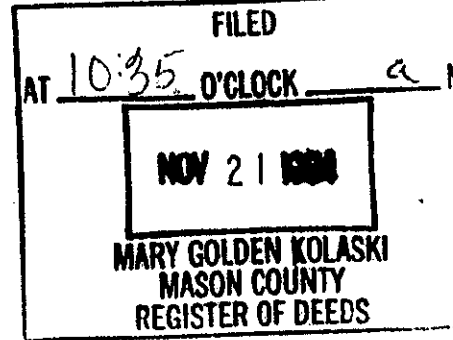

Register of Deeds Stamp & File Number

4. Lot No. _____, Recorded Plat _____
 5. Private Claims _____

A	B	C	D	E	F	G	H	I	J	K	L	M
2	6	5	4	3	2	1						
3												
4	7	8	9	10	11	12						
5												
6	18	17	16	15	14	13						
7												
8	19	20	21	22	23	24						
9												
10	30	29	28	27	26	25						
11												
12	31	32	33	34	35	36						
13												

1. John Schulke, in a field survey on Nov. 3, 1994, do hereby certify that under requirements of P.A. 74, Michigan P.A. of 1970, the corner points mentioned in lines 1 and 2 above were in conformance with regulations and rules therefore as required in the current manual of survey instructions of the United States Department of the Interior, Bureau of Land Management or by a decree of a Court of Law and/or that the corner points mentioned in lines 3, 4 and 5 above were in conformance with the rules of the Michigan Board of Land Surveyors or by a Decree of a Court of Law; established, re-established, monumented, re-monumented, recovered, found as expressed below:


NOTE: Not more than 4 corners, all in the same town and range, may be recorded on this certificate.

A. Description of original monument and accessories and/or subsequent restoration:
 Original survey established in 1838 by Sibley.
 Set a wooden post with the following references:
 1. Beech 8" N03°E 41 lks.
 2. Beech 6" S10°W 22 lks.
 In 1914, CE Mitchill (see Book 2, Pages 190 & 191) Southwest corner identified by stake and resident land owner and East, West, North, South roads.
 No references:
 Unknown date, Mason Co. Rd. Comm. indicated 1" iron stake with the following corner references:
 3. Norway pine 12" NW 61 ft.
 4. Poplar 12" NE 60 ft.

5. Norway 12" SE 66 ft.
 6. Fence corner SW 40.9 ft.
 Barnett Survey records indicate with the following corner references:
 7. Power pole NW 52.2 ft.
 8. Fence corner NE 35.5 ft.
 9. Fence corner SW 43.6 ft.
 10. Norway pine NW 61.57 ft.

In 1984, D. Dunlap indicated found 1/2" iron pipe (see corner certificate Liber 2, Page 217) with the following corner references:
 11. Oak 16" S85°30'E 13.26 ft.
 CONTINUE ON BACK

B. Description of corner evidence found and/or method applied in restoring or reestablishing corner:
 Recovered 3/4" iron pipe (6 in. below the surface of the road).
 References #3 and 10 are the same-recovered
 References #7-recovered
 References # 6 and 9-changed
 All other references are gone.

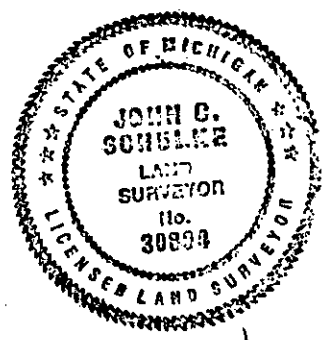

C. Description of monument for corner and accessories established to perpetuate localing the position of the corner:
 Replaced 3/4" iron pipe with 5/8"X2' rerod with an aluminum cap monument stamped to identify the corner. The monument is 1 ft. below the surface of the road (Cross roads of Dewey & Taylor). The following corner references:
 R Pine 25" N69°W 61.57 ft.
 corner post S51°W 47.97 ft.
 Power pole N35°W 52.57 ft.
 R pine 12" S25°E 63.95 ft. (scribed)
 R Maple 8" S74°W 103.45 ft. (scribed)

(NOTE: Corner is accepted as the best evidence of the perpetuated location of the original corner).

Date: 11-16-94
Kenneth L. Ross
 Mason County Surveyor

Signed by John C Schulke
 Surveyor's Michigan License No. PLS-30894

Date Nov. 11, 1994

Date: Feb 25 1997
Kenneth L. Ross

Continued column "A": I-9

12.	Maple	6"	N24°E	28.40 ft.
13.	Oak	6"	N24°W	37.39 ft.
14.	R Pine	18"	N25°E	61.08 ft.
7.	Power pole		N50°E	52.73 ft.