

# SURVEY & REMONUMENTATION


APR 28 1995

## COMMISSION LAND CORNER RECORDATION CERTIFICATE

Filing Requirement of Act 74, Mich. P.A. 1970

For corners in

<u>MASON</u> <small>(County)</small>	Located In:	Corner Code #:
1. Public Land Survey	T <u>19N</u> R <u>15W</u>	<u>I-12</u>
	T _____ R _____	
	T _____ R _____	
	T _____ R _____	
2. Property Controlling in Section	S _____ T _____ R _____	<u>Seg. 1</u>
	S _____ T _____ R _____	
3. Miscellaneous Property in Sec.	S _____ T _____ R _____	
	S _____ T _____ R _____	
4. Lot No. _____, Recorded Plat _____		
5. Private Claims _____		

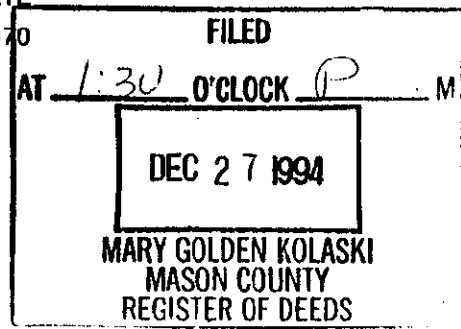

Register of Deeds Stamp & File Number

	A	B	C	D	E	F	G	H	I	J	K	L	M
2	6	5	4	3	2								
3													
4	7	8	9	10	11	12							
5													
6	18	17	16	15	14	13							
7													
8	19	20	21	22	23	24							
9													
10	30	29	28	27	26	25							
11													
12	31	32	33	34	35	36							
13													

I, John Schulke, in a field survey on Nov. 5th, 1994, do hereby certify that under requirements of P.A. 74, Michigan P.A. of 1970, the corner points mentioned in lines 1 and 2 above were in conformance with regulations and rules therefore as required in the current manual of survey instructions of the United States Department of the Interior, Bureau of Land Management or by a decree of a Court of Law and/or that the corner points mentioned in lines 3, 4 and 5 above were in conformance with the rules of the Michigan Board of Land Surveyors or by a Decree of a Court of Law; established, re-established, monumented, re-monumented, recovered, found as expressed below:

**NOTE: Not more than 4 corners, all in the same town and range, may be recorded on this certificate.**

A. Description of original monument and accessories and/or subsequent restoration:  
Original survey established in 1838 by Sibley. In 1984, D. Dunlap found iron (see corner certificate Liber 2, page 222).  
Set a wooden post with the following references:


1. Beech 12" N59°E 27 lks.
2. Maple 12" S42°W 10 lks.

In 1896, J.W. Griswold (see Book 1, Page 203) set by measurement and no ties.  
3. NE corner of Section 34 North 38.89 chains  
4. SE corner of Section 34 South 38.99 chains

In 1938, Survey by Lunde set iron stake.  
5. corner fence post (steel) N66°W 37.9 ft.  
NE Corner of Sec. 34 N01°W 2566.0 ft.  
SE corner of Sec. 34 S01°E 2566.0 ft.

B. Description of corner evidence found and/or method applied in restoring or reestablishing corner:

Found 1" iron pipe pinched on bottom.  
NE corner of Section 34 N0°53'00"E 2665.27 ft. (Grid-bearing & distances)  
SE corner of Section 34 S0°53'27"W 2665.92 ft.

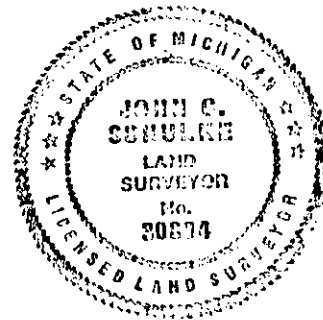

C. Description of monument for corner and accessories established to perpetuate locating the position of the corner:  
Replaced 1" iron pipe with 5/8"x36" rod with an aluminum cap monument stamped to identify the corner.  
The monument 1 ft. below the surface of the road. The center line of Taylor Rd. is West 3 ft. and the center line of Stolberg Rd. is South 3 ft. The following corner references:

- |                                  |       |                               |
|----------------------------------|-------|-------------------------------|
| Chiseled "X" on Boulder 6'X4'X3' | S60°W | 60.13 ft.                     |
| Power pole                       | N40°E | 31.93 ft.                     |
| Power pole                       | N41°W | 39.35 ft.                     |
| Ash 15"                          | S14°E | 101.90 ft.                    |
| R Oak 15"                        | N30°W | 113.52 ft. (scribed & blazed) |

(NOTE: Accepted record 1" iron pipe as a proper re-establishment for the position of the original corner.)

Signed by John C. Schulke Date Nov. 7, 1994  
Surveyor's Michigan License No. PLS-30894

Peer Group Reviewed  
and Approved  
Date: Nov 7, 1994  
Kenneth L. Ross  
Mason County Surveyor

FORM APPROVED BY MICHIGAN STATE BOARD OF LAND SURVEYORS, JAN. 28, 1971  
REVISED MAY 14, 1975  
REVISED JAN., 1983