

**LAND CORNER RECORDATION CERTIFICATE**  
**Filing Requirement of Act 74, Mich. P.A. 1970**

For corners in

MASON \_\_\_\_\_ Located In: \_\_\_\_\_ Corner Code *11*  
 (County)

1. Public Land Survey T 19 N. R 15 W I-13  
 T R  
 T R  
 T R  
 T R

2. Property Controlling S T R  
 in Section S T R  
 3. Miscellaneous S T R  
 Property in Sec. S T R

4. Lot No. \_\_\_\_\_, Recorded Plat \_\_\_\_\_  
 5. Private Claims \_\_\_\_\_

*Seg. 1*

FILED  
 AT 11:10 O'CLOCK a M  
**OCT - 7 1994**  
 MARY GOLDEN KOLASKI  
 MASON COUNTY  
 REGISTER OF DEEDS  
 Register of Deeds Stamp & File Number

I, Sammy S. Barnett, in a field survey on September 20, 1994, do hereby certify that under requirements of P.A. 74, Michigan P.A. of 1970, the corner points mentioned in lines 1 and 2 above were in conformance with regulations and rules therefore as required in the current manual of survey instructions of the United States Department of the Interior, Bureau of Land Management or by a decree of a Court of Law and/or that the corner points mentioned in lines 3, 4 and 5 above were in conformance with the rules of the Michigan Board of Land Surveyors or by a Decree of a Court of Law; established, re-established, monumented, re-monumented, recovered, found as expressed below:

**NOTE: Not more than 4 corners, all in the same town and range, may be recorded on this certificate.**

A	B	C	D	E	F	G	H	I	J	K	L	M
2	6	5	4	3	2	1						
3												
4	7	8	9	10	11	12						
5												
6	18	17	16	15	14	13						
7												
8	19	20	21	22	23	24						
9												
10	30	29	28	27	26	25						
11												
12	31	32	33	34	35	36						
13												

**A. Description of original monument and accessories and/or subsequent restoration:**

I-13 SouthWest corner, Section 35, on the Township Line

1838, G.L.O., John Mullette  
 Set wood post  
 #1 Maple 10" N 72° E 311k(20.46')  
 #2 Maple 6" N 41° W 241k(15.84')

E. LUNDE  
1938, K. Stephens, C.S.  
 Monument not given, used corner  
 in Survey in Sec. 34, 119N-R15W

#3 S. Maple 8" NW 65.48'  
 #4 W. Oak 4" SE 22.34'  
 #5 Power Pole SW 39.25'

1904 R.O. Towns, C.S.  
 Uses corner to set NW cor., Sec. 2  
 T18N - R15W

1965, K. Stephens, C.S.  
 Replaced bent 1" iron pipe with  
 1" iron pipe

1971, R.A. Griffin, P.S.  
 Found 1" Iron Pipe, replaced with  
 5" squ. conc. Monument. (OVER)

**B. Description of corner evidence found and/or method applied in restoring or reestablishing corner:**

I-13 SouthWest corner, Section 35, on the Township Line

On September 20, 1994, I found 5" square x 36" Concrete Monument with 3" brass cap, found South of center-line of Decker Road 1 foot below Road surface.

Condition of recorded witnesses is; #1 Gone #2 Gone #3 Gone #4 Gone #5 found in good cond.  
 #6 Gone #7 Gone #8 Same as #4 #9 Same as #5 #10 found in fair cond. #11 found in good cond.

**C. Description of monument for corner and accessories established to perpetuate locating the position of the corner:**


I-13 SouthWest corner, Section 35, on the Township Line

Accepted 5" x 36" concrete monument with brass cap (U.S.F.S.) as a substantial marker for the corner, and is accepted as a careful and faithful reestablishment of the position of the original corner.

(OBT #11) Center of brass cap of concrete monu, East 22.44'  
 S. Maple Clump 10"-8" N 38° E 157.68' (60d spike in SE side of tree)  
 R. Oak 5" N 23° W 157.20' (60d spike in NE side of tree)  
 B. Oak 12" N 50° W 147.58' (60d spike in NE side of tree)

Signed by Sammy S. Barnett  
 Surveyor's Michigan License No. 16923

Date 10/4/94

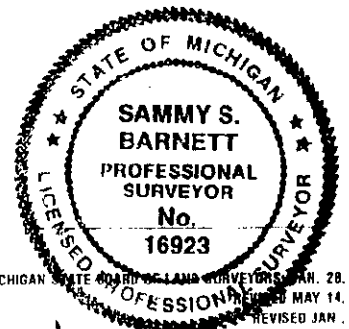

FORM APPROVED BY MICHIGAN STATE BOARD OF LAND SURVEYORS, JAN. 28, 1971  
 DATE 10-5-94  
 [Signature]

1971, R.A. Griffin P.S.

- #6 W. Oak 5" N 37° W 114.32'
- #7 Iron 3" x 3" N 15° W 79.37'
- #8 W. Oak 4" SE 22.34'
- #9 Power Pole SW 39.25'
- #10 Pine Post 4" x 7" N 45° W 46.83'
- #11 Center of bro p of conc. monument  
East 22.44'