

SURVEY & REMONUMENTATION

MAR 16 1998

LAND CORNER RECORDATION CERTIFICATE
Filing Requirement of Act 74, Mich. P.A. 1970

SECTION
For corners in

MASON (County)	Located In:	Corner Code --
1. Public Land Survey	T 19N R 15W	J-11
	T . R	
	T . R	
	T . R	
2. Property Controlling in Section	S . T . R	Sg. 2
	S . T . R	
3. Miscellaneous Property in Sec.	S . T . R	
	S . T . R	

FILED
AT 2:45 O'CLOCK P.1
DEC 22 1994
MARY GOLDEN KOLASKI
MASON COUNTY
REGISTER OF DEEDS
Register of Deeds Stamp & File Number

4. Lot No. _____, Recorded Plat _____
5. Private Claims _____

I, Sammy S. Barnett, in a field survey on December 6, 19 94, do hereby certify that under requirements of P.A. 74, Michigan P.A. of 1970, the corner points mentioned in lines 1 and 2 above were in conformance with regulations and rules therefore as required in the current manual of survey instructions of the United States Department of the Interior, Bureau of Land Management or by a decree of a Court of Law and/or that the corner points mentioned in lines 3, 4 and 5 above were in conformance with the rules of the Michigan Board of Land Surveyors or by a Decree of a Court of Law; established, re-established, monumented, re-monumented, recovered, found as expressed below:

	A	B	C	D	E	F	G	H	I	J	K	L
2	6		5		4		3		2		1	
3												
4	7		8		9		10		11		12	
5												
6	18		17		16		15		14		13	
7												
8	19		20		21		22		23		24	
9												
10	30		29		28		27		26		25	
11												
12	31		32		33		34		35		36	
13												

NOTE: Not more than 4 corners, all in the same town and range, may be recorded on this certificate.

A. Description of original monument and accessories and/or subsequent restoration:

J-11 1/4 Corner for Sections 26 & 35, T19N, R15W.

1838, G.L.O., Sylvester Sibley

Set Wood Post

#1 W. Oak 12" N 50° E 61k(3.96')

#2 Beech 8" S 31° W 171k(11.22')

B. Description of corner evidence found and/or method applied in restoring or reestablishing corner:

J-11 1/4 Corner for Sections 26 & 35, T19N, R15W.

On December 6, 1994, Kevin Pritchard and I, recovered the location of old woven wire fence corner, ^{we} reestablished where a fence running South and where a fence running East intersected for the position of the 1/4 Corner. This position was presented to the Mason County Surveyors Peer Review Committee for discussion. It is believed that due to the lack of any confirmed G. L. O. witnesses or other G. L. O. evidence, that the old fence intersection is the best available position for the 1/4 corner. Mason County Surveyors Peer Review Committee also agreed with this position.

Note: There is a previously file Act 74, on this Corner, filed by Jacl C. Schulke R.L.S. # 30894, see Liber 3 Page 28, Mason County Corner Records.

Condition of recorded witness is; #1 Gone #2 Gone

C. Description of monument for corner and accessories established to perpetuate locating the position of the corner:

J-11 1/4 Corner for Sections 26 & 35, T19N, R15W.

Set a 5/8" x 24" Re-Rod with an aluminum cap 2 1/2" in dia., stamped Mason County Monument. And is accepted as the best available evidence of the position of the original corner.

W. Oak 6" S 62° E 21.95' (60d spike in SW side of tree)

B. Oak 10" S 45° W 31.94' (60d spike in NW side of tree)


W. Oak 7" N 72° W 42.94' (60d spike in NE side of tree)

W. Oak 6" N 08° E 28.57' (60d spike in SE side of tree)

Concrete plat monument with R.L.S. cap #30894 N 17° W 41.82'

Signed by Sammy S. Barnett Date 12-6-94

Surveyor's Michigan License No. 16923 Peer Group Reviewed and Approved

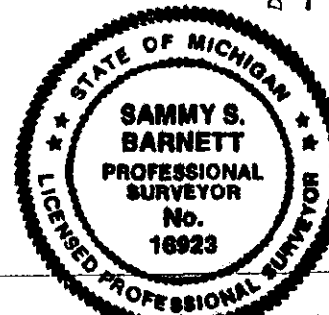

Peer Group Reviewed and Approved
Date: Dec 5, 1994
Kenneth L. Ross

LIBER 3 PAGE 247

Date: Dec 5, 1994
Kenneth L. Ross
Mason County Surveyor