


SURVEY & REMONUMENTATION

MAR 16 1998

LAND CORNER RECORDATION CERTIFICATE
Filing Requirement of Act 74, Mich. P.A. 1970

For corners in SECTION
MASON (County)

1. Public Land Survey Located In: T 19 N R 15 W Corner Code # J-13
T R
T R
T R
T R
2. Property Controlling in Section S T R
S T R
3. Miscellaneous Property in Sec. S T R
S T R
4. Lot No. _____, Recorded Plat _____
5. Private Claims _____

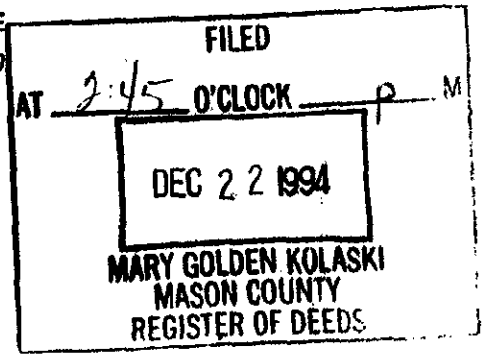

Register of Deeds Stamp & File Number

	A	B	C	D	E	F	G	H	I	J	K	L	M
2	6	5	4	3	2								
3													
4	7	8	9	10	11	12							
5													
6	18	17	16	15	14	13							
7													
8	19	20	21	22	23	24							
9													
10	30	29	28	27	26	25							
11													
12	31	32	33	34	35	36							
13													

I, Sammy S. Barnett, in a field survey on October, 1994, do hereby certify that under requirements of P.A. 74, Michigan P.A. of 1970, the corner points mentioned in lines 1 and 2 above were in conformance with regulations and rules therefore as required in the current manual of survey instructions of the United States Department of the Interior, Bureau of Land Management or by a decree of a Court of Law and/or that the corner points mentioned in lines 3, 4 and 5 above were in conformance with the rules of the Michigan Board of Land Surveyors or by a Decree of a Court of Law; established, re-established, monumented, re-monumented, recovered, found as expressed below:

NOTE: Not more than 4 corners, all in the same town and range, may be recorded on this certificate.

A. Description of original monument and accessories and/or subsequent restoration:

- J-13 South 1/4 corner for Section 35, T19N, R15W, on the township line.
- | | |
|---|--|
| <u>1838, G.L.O., John Mullette</u>
Set Wood Post | <u>1968, K.B. Stephens, RLS # 7318</u>
Set 1" Iron Pipe |
| #1 Beech 8" N 56° W 231k(15.18') | #3 Tw. Oak 10" & 4" NNW 33.52' |
| #2 Beech 7" N 30° E 321k(21.12') | #4 Tw. B. Oak 12" NNW 55.08' |
| | #5 Closing corner 18.53' East |

J. Schulke, PS # 30894
In 1990 could not locate any marker for corner, so re-set 1" Iron Pipe from record distance from survey of Dennis Dunlap, L270, P768, 2645.48' from SW Cor.
#6 W. Oak 14" N08°W 33.57'
#7 B. Oak 12" S16° E 89.90'
#8 1/2" Re-Rod P.S. cap N02°E 33.06'

B. Description of corner evidence found and/or method applied in restoring or reestablishing corner:

- J-13 South 1/4 corner for Section 35, T19N, R15W, on the township line.

On October 20, 1994, I found 1" Iron Pipe in center of Decker Road, an found no conflicting evidence to disputed its location.

Condition of recored witnesses is; #1 Gone #2 Gone #3 Gone #4 Found in good cond. #5 Measured 18.07 feet #6 Found in good cond. #7 Found in good cond. #8 Found in good cond.

C. Description of monument for corner and accessories established to perpetuate locating the position of the corner:

- J-13 South 1/4 corner for Section 35, T19N, R15W, on the township line.

Replaced 1" Iron Pipe with a 5/8" x 24" Re-Rod with 2 1/2" aluminum cap, stamp MASON COUNTY MONUMENT, set 1 foot below gravel road surface, and is a careful and faithful reestablishment of the position of the original corner.

- Twin Black Oak 16"-16" N 43° W 44.62' (60d spike in SW side of tree.)
- (OBT #6) W. Oak 15" N 10° W 33.57' (60d spike in NE side of tree)
- (OBT #7) B. Oak 15" S 18° E 89.78' (60d spike in NE side of tree)
- 1/2" Re-Rod PS cap # 21759 N 02° E 33.06'

Signed by Sammy S. Barnett
Surveyor's Michigan License No. 16923

Date 11-16-94

Peer Group Reviewed and Approved

Date: 12-25-94
Kenneth L. Foss
Mason County Surveyor

Peer Group Reviewed and Approved
Date: 11-16-94
Kenneth L. Foss
Mason County Surveyor



FORM APPROVED BY MICHIGAN STATE BOARD OF PROFESSIONAL SURVEYORS, 1971
REVISED JAN., 1983