

**SURVEY &  
REMONUMENTATION**

APR 28 1995

**COMMISSION**

**LAND CORNER RECORDATION CERTIFICATE**  
Filing Requirement of Act 74, Mich. P.A. 1970


For corners in

MASON (County) Located In: Corner Code #

1. Public Land Survey T 19N R 15W K-10  
T \_\_\_\_\_ R \_\_\_\_\_  
T \_\_\_\_\_ R \_\_\_\_\_  
T \_\_\_\_\_ R \_\_\_\_\_

2. Property Controlling S \_\_\_\_\_ T \_\_\_\_\_ R \_\_\_\_\_  
in Section S \_\_\_\_\_ T \_\_\_\_\_ R \_\_\_\_\_

3. Miscellaneous S \_\_\_\_\_ T \_\_\_\_\_ R \_\_\_\_\_  
Property in Sec. S \_\_\_\_\_ T \_\_\_\_\_ R \_\_\_\_\_

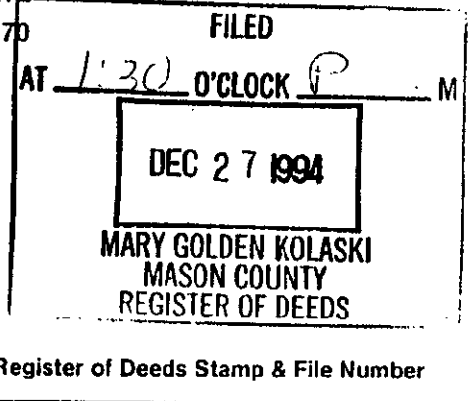

4. Lot No. \_\_\_\_\_, Recorded Plat \_\_\_\_\_

5. Private Claims \_\_\_\_\_

A	B	C	D	E	F	G	H	I	J	K	L	M
2	6	5	4	3	2							
3												
4	7	8	9	10	11	12						
5												
6	18	17	16	15	14	13						
7												
8	19	20	21	22	23	24						
9												
10	30	29	28	27	26	25						
11												
12	31	32	33	34	35	36						
13												

I, John C. Schulke, in a field survey on Nov. 12, 19 94, do hereby certify that under requirements of P.A. 74, Michigan P.A. of 1970, the corner points mentioned in lines 1 and 2 above were in conformance with regulations and rules therefore as required in the current manual of survey instructions of the United States Department of the Interior, Bureau of Land Management or by a decree of a Court of Law and/or that the corner points mentioned in lines 3, 4 and 5 above were in conformance with the rules of the Michigan Board of Land Surveyors or by a Decree of a Court of Law; established, re-established, monumented, re-monumented, recovered, found as expressed below:

**NOTE: Not more than 4 corners, all in the same town and range, may be recorded on this certificate.**

**A. Description of original monument and accessories and/or subsequent restoration:**

In 1838, original survey established by Sibley.  
Set a wood post at the corner with the following corner references:  
1. W Oak 10" S87°E 25 lks.  
2. W Oak 10" N65°W 4 lks.

In 1984, D. Dunlap computed the position by proportionate measurement and nothing set (see Liber 2, page 216 of LCRC) in the Mason Co. Court House.  
(note: no comment on ancient fence corner to the North of computed position).

In 1989, Hayes surveyed for Mr. Gillette (see file #PS89-75)


In 1990, Schulke noted the fence corner on the LCRC (see Liber 3, page 29).

In 1993, see LCRC Liber 3, page 92 for information by John Schulke. Considering the ancient fence corner as the best available evidence as to the location of an obliterated GLO corner & a "practical location". Set 1" capped iron pipe at fence corner with the following blazed & scribed bearing trees:  
W Oak 5" N66°E 7.85 ft.  
Blk. Oak 16" South 11.70 ft.  
W Oak 4" N57°W 17.14 ft.

**B. Description of corner evidence found and/or method applied in restoring or reestablishing corner:**

Found 1" dia. iron pipe with cap and corner references as described on LCRC of Liber 3, page 92. Found ancient fence also running North from the corner. Monument for Southeast corner of Section 26 is S2°04'57"W a distance of 2642.48 ft. (Grid Bearing). Nordlund & Associates capped iron is S2°19'W 172.87 ft. from Schulke's iron pipe. using solar observation and the Grid bearings S03°31'13"W a distance of 172.86 ft.

**NOTE: In 1989, Nordlund & Associates survey indicate corner for Gillette in Section 26, (see file #PS89-75).**

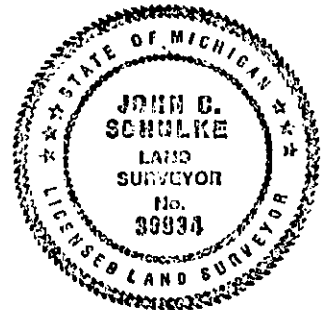

**C. Description of monument for corner and accessories established to perpetuate locating the position of the corner:**

Accepted 1" capped pipe as the best available evidence of the position of the original corner & replaced it with a 5/8" X 2' rerod with an aluminum County cap stamped to identify the corner. Rerod at the inter-section of fence corner.  
The following corner references:

- 12" Red Oak S60°E 28.37 ft.
- 16" W Oak S01°E 11.73 ft. (Note: wire in tree on West side).
- 10" W Oak S64°W 1.30 ft. (Note: wire running South & West out of tree on North side).
- 6" W Oak N71°E 7.84 ft.
- 6" W Oak N51°W 17.15 ft.

Signed by John C. Schulke Date Dec 5, 1994  
Surveyor's Michigan License No. 30894

Peer Group Reviewed and Approved

FORM APPROVED BY MICHIGAN STATE BOARD OF LAND SURVEYORS, JAN 28, 1971  
REVISED MAY 14, 1975  
REVISED JAN., 1983

Date: 12-27-94  
Kenneth L. Ross  
Mason County Surveyor