

SURVEY & REMONUMENTATION

MAR 16 1998

SECTION

LAND CORNER RECORDATION CERTIFICATE
Filing Requirement of Act 74, Mich. P.A. 1970

For corners in

MASON


(County)

Located In:

Corner Code: #

- 1. Public Land Survey T 19N R 15W K-12
- T R
- T R
- T R
- 2. Property Controlling S T R
- in Section S T R
- 3. Miscellaneous S T R
- Property in Sec. S T R

Sec. 2

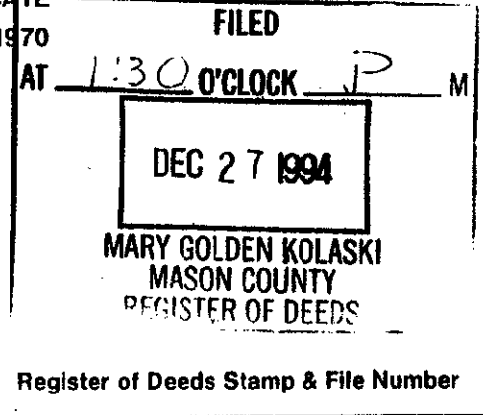

- 4. Lot No. _____, Recorded Plat _____
- 5. Private Claims _____

A	B	C	D	E	F	G	H	I	J	K	L	M
2	6	5	4	3	2	1						
3												
4	7	8	9	10	11	12						
5												
6	18	17	16	15	14	13						
7												
8	19	20	21	22	23	24						
9												
10	30	29	28	27	26	25						
11												
12	31	32	33	34	35	36						
13												

I, John C. Schulke, in a field survey on Nov. 26, 1994, do hereby certify that under requirements of P.A. 74, Michigan P.A. of 1970, the corner points mentioned in lines 1 and 2 above were in conformance with regulations and rules therefore as required in the current manual of survey instructions of the United States Department of the Interior, Bureau of Land Management or by a decree of a Court of Law and/or that the corner points mentioned in lines 3, 4 and 5 above were in conformance with the rules of the Michigan Board of Land Surveyors or by a Decree of a Court of Law established, re-established, monumented, re-monumented, recovered, found as expressed below:

NOTE: Not more than 4 corners, all in the same town and range, may be recorded on this certificate.

A. Description of original monument and accessories and/or subsequent restoration:

In 1838, original survey established by Sibley. Set a wood post at the corner with the following corner references: 10" W Oak N86°E 10 lks. 8" W Oak N56°W 22 lks.

In 1984, D. Dunlap computed the position see LCRC of Liber 2, page 220.


In 1990, Schulke set 1"X30" capped iron pipe. Restored corner by single proportionate measurement as the best available method to reestablish the position of the original corner. The following corner references were blazed and scribed:

- 18" Twin W Oak N35°E 25.72 ft.
- 12" W Oak N61°W 25.40 ft.
- 11" R Pine S74°E 33.28 ft.
- 15" R Oak S66°W 22.72 ft.

ancient fence line running North-South is 14 ft. West of the corner.

B. Description of corner evidence found and/or method applied in restoring or reestablishing corner:

Found 1" iron pipe set by J. Schulke from Nordlund & Associates notes in 1979.

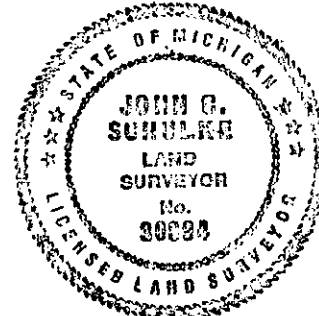

C. Description of monument for corner and accessories established to perpetuate locating the position of the corner:

Did not accept the pipe and pulled it. Restored corner by single proportionate measurement as the best available method to reestablish the position of the original corner. Set 5/8"X3" rebar with a aluminum County Cap to identify the corner with the following corner references:

- 16" W Oak N41°E 26.60 Ft.
- 10" R Pine S71°E 33.34 Ft.
- 18" R Oak S71°W 22.41 Ft.
- 13" W Oak N55°W 25.57 Ft.

ancient woven fence running South-North is West 14 ft. of the corner. 6"X6" treated post North 0.7 ft. of the corner.

Peer Group Reviewed and Approved
Date: 12-5-94
Kenneth L. Finner
Michigan State Board of Land Surveyors

Signed by John C. Schulke
Surveyor's Michigan License No. 30894

Date 12-05-94

Peer Group Reviewed and Approved
Date: 12-5-94
Kenneth L. Finner