

SURVEY & REMONUMENTATION


APR 28 1995

COMMISSION

LAND CORNER RECORDATION CERTIFICATE
 Filing Requirement of Act 74, Mich. P.A. 1970

For corners in

MASON _____	Located In:	Corner Code #:
(County)		
1. Public Land Survey	T 19N R 15W	L-9
	T _____ R _____	_____
	T _____ R _____	_____
	T _____ R _____	_____
2. Property Controlling in Section	S _____ T _____ R _____	_____
	S _____ T _____ R _____	_____
3. Miscellaneous Property in Sec.	S _____ T _____ R _____	_____
	S _____ T _____ R _____	_____

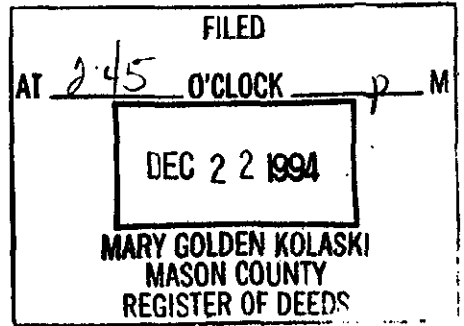

Register of Deeds Stamp & File Number

4. Lot No. _____, Recorded Plat _____
 5. Private Claims _____

	A	B	C	D	E	F	G	H	I	J	K	L	M
2	6		5		4		3		2		1		
3													
4	7		8		9		10		11		12		
5													
6	18		17		16		15		14		13		
7													
8	19		20		21		22		23		24		
9													
10	30		29		28		27		26		25		
11													
12	31		32		33		34		35		36		
13													

I, Sammy S. Barnett, in a field survey on December 6, 19 94, do hereby certify that under requirements of P.A. 74, Michigan P.A. of 1970, the corner points mentioned in lines 1 and 2 above were in conformance with regulations and rules therefore as required in the current manual of survey instructions of the United States Department of the Interior, Bureau of Land Management or by a decree of a Court of Law and/or that the corner points mentioned in lines 3, 4 and 5 above were in conformance with the rules of the Michigan Board of Land Surveyors or by a Decree of a Court of Law; established, re-established, monumented, re-monumented, recovered, found as expressed below:

NOTE: Not more than 4 corners, all in the same town and range, may be recorded on this certificate.

A. Description of original monument and accessories and/or subsequent restoration:

L-9 1/4 corner for Sections 24 & 25, T19N, R15W.

1838, G.L.O., Sylvester Sibley
 Set Wood Post
 #1 Maple 8" S 86° W 181k (11.88')
 #2 Beech 6" S 55° E 161k (10.56')

B. Description of corner evidence found and/or method applied in restoring or reestablishing corner:

L-9 1/4 Corner for Sections 24 & 25, T19N, R15W.

On December 6, 1994, Kevin Pritchard, Jack Schulke and I search a computed location for any evidence or witnesses to the original corner, also search for old fences and other occupation, but found none. Due to lack of any evidence of original corner we set corner using single proportional method, set half-way on line between NW corner section 24 and the NE corner section 25, computed a Grid bearing of S 89°-20'-40" E, and a split distance of 2655.68', against G.L.O. distance of 2643.30'. Condition of recorded witnesses is; #1 Gone #2 Gone

C. Description of monument for corner and accessories established to perpetuate locating the position of the corner:

L-9 1/4 Corner for Sections 24 & 25, T19N, R15W.


Set a 2 1/4" steel pipe, 30" long with a brass cap 3 1/4 in dia., stamped accordingly. And is accepted as the best available evidence of the position of the original corner.

R. Oak 4" N 13° W 53.47'
 Clump of Maple S 15° W 8.32' (60d spike in NW side of 6" Maple)
 R. Oak 5" N 55° E 43.45'
 W. Oak 14" S 68° E 57.61'
 23' to the center-line of two-track, due East

Signed by Sammy S. Barnett Date 12-6-94

Surveyor's Michigan License No. 16923

Peer Group Reviewed and Approved
 Date: 12-5-94
Kenneth L. Ross
 Mason County Surveyor

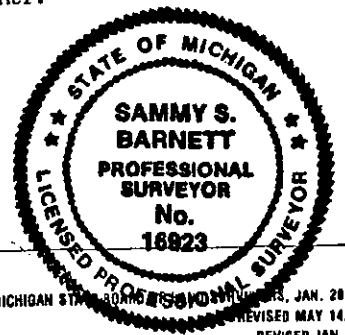

FORM APPROVED BY MICHIGAN STATE BOARD OF PROFESSIONAL SURVEYORS, JAN. 20, 1971
 REVISED MAY 14, 1975
 REVISED JAN., 1983

LIBER 3 PAGE 245