

SURVEY & REMONUMENTATION

MAR 16 1998

SECTION

LAND CORNER RECORDATION CERTIFICATE
Filing Requirement of Act 74, Mich. P.A. 1970

For corners in

MASON


(County)

Located In:

Corner Code #:

- 1. Public Land Survey T 19N R 15W
- T _____ R _____
- T _____ R _____
- T _____ R _____
- 2. Property Controlling S _____ T _____ R _____
- in Section S _____ T _____ R _____
- 3. Miscellaneous S _____ T _____ R _____
- Property in Sec. S _____ T _____ R _____

Seg-2

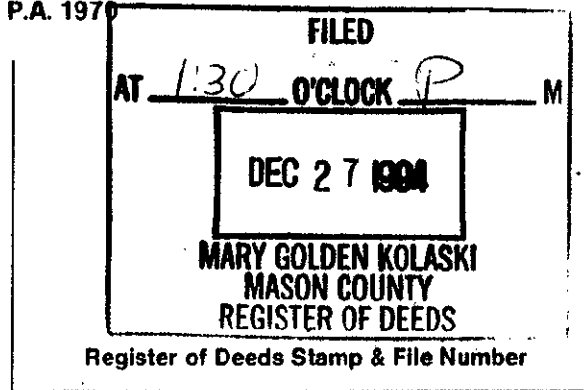

- 4. Lot No. _____, Recorded Plat _____
- 5. Private Claims _____

I, John C. Schulke, in a field survey on Dec. 8th, 19 94, do hereby certify that under requirements of P.A. 74, Michigan P.A. of 1970, the corner points mentioned in lines 1 and 2 above were in conformance with regulations and rules therefore as required in the current manual of survey instructions of the United States Department of the Interior, Bureau of Land Management or by a decree of a Court of Law and/or that the corner points mentioned in lines 3, 4 and 5 above were in conformance with the rules of the Michigan Board of Land Surveyors or by a Decree of a Court of Law; established, re-established; monumented, re-monumented, recovered, found as expressed below:

NOTE: Not more than 4 corners, all in the same town and range, may be recorded on this certificate.

	A	B	C	D	E	F	G	H	I	J	K	L	M
2	6	5	4	3	2	1							
3													
4	7	8	9	10	11	12							
5													
6	18	17	16	15	14	13							
7													
8	19	20	21	22	23	24							
9													
10	30	29	28	27	26	25							
11													
12	31	32	33	34	35	36							
13													

A. Description of original monument and accessories and/or subsequent restoration:
 In 1838, original survey established by Sibley.


Set a wood post with the following corner references:

- 1. W Oak 8" N73°E 10 lks.
- 2. Maple 8" S46°W 12 lks.

B. Description of corner evidence found and/or method applied in restoring or reestablishing corner:

Kevin Pritchard and I, searched and found old cutting line running North and East from single proportional position between K-11 (see LCRC Liber 3, page 29) and M-11. Corner references # 1 and #2 was not recovered. Restored corner by single proportional measurement.

- K-11 N87°43'33"W 2657.01 ft.
- M-11 S87°43'33"E 2657.01 ft. Grid Bearing and Distances.

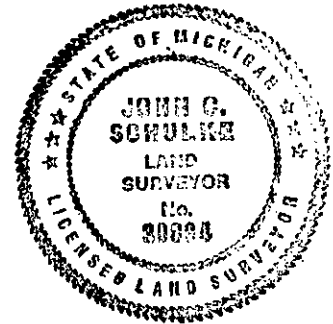

C. Description of monument for corner and accessories established to perpetuate locating the position of the corner:

Set 2"X30" long ID steel pipe with a brass cap stamped to identify the corner RLS-16923 stamped on the monument, Position approved.

The following corner references:

- 12" B Oak S30°E 14.65 ft.
- 21" B Oak S30°W 8.21 ft.
- 4" clump of R Maple N64°W 17.13 ft.
- 7" Twin R Maple N14°E 23.67 ft.

NOTE: Corner is accepted as a careful and faithful restoration of the position of the original corner.

Peer Group Reviewed and Approved
 Date: 12-5-94
 Kenneth L. Ross
 Mason County Surveyor

Signed by John C. Schulke
 Surveyor's Michigan License No. 30894

Date Dec 5, 1994

Peer Group Reviewed and Approved
 Date: 12-5-94