

**SURVEY &  
REMONUMENTATION**


APR 28 1995

COMMISSION

**LAND CORNER RECORDATION CERTIFICATE**  
Filing Requirement of Act 74, Mich. P.A. 1970

For corners in

MASON (County)	Located In:	Corner Code --#
1. Public Land Survey	T 19 N R 15 W	M-7
	T _____ R _____	
	T _____ R _____	
	T _____ R _____	
2. Property Controlling In Section	S _____ T _____ R _____	
	S _____ T _____ R _____	
3. Miscellaneous Property in Sec.	S _____ T _____ R _____	
	S _____ T _____ R _____	

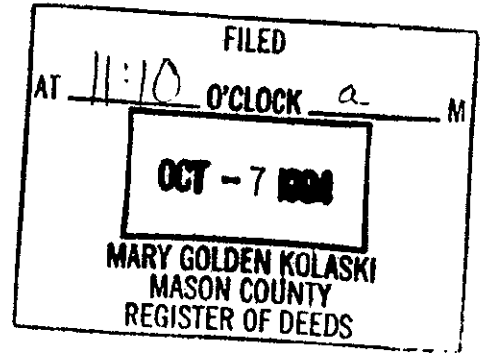

Register of Deeds Stamp & File Number

4. Lot No. \_\_\_\_\_, Recorded Plat \_\_\_\_\_  
5. Private Claims \_\_\_\_\_

I, Sammy S. Barnett, in a field survey on September 23, 1994, do hereby certify that under requirements of P.A. 74, Michigan P.A. of 1970, the corner points mentioned in lines 1 and 2 above were in conformance with regulations and rules therefore as required in the current manual of survey instructions of the United States Department of the Interior, Bureau of Land Management or by a decree of a Court of Law and/or that the corner points mentioned in lines 3, 4 and 5 above were in conformance with the rules of the Michigan Board of Land Surveyors or by a Decree of a Court of Law; established, re-established, monumented, re-monumented, recovered, found as expressed below:

**NOTE: Not more than 4 corners, all in the same town and range, may be recorded on this certificate.**

	A	B	C	D	E	F	G	H	I	J	K	L	M
2	6	5	4	3	2	1							
3													
4	7	8	9	10	11	12							
5													
6	18	17	16	15	14	13							
7													
8	19	20	21	22	23	24							
9													
10	30	29	28	27	26	25							
11													
12	31	32	33	34	35	36							
13													

A. Description of original monument and accessories and/or subsequent restoration:

M-7 Section corner, Sec's., 13 & 24 on the County Line

1838, G.L.O., John Mullette  
Set Wood Post

#1 B. Ash 10" S 77° W 91k(5.94')  
#2 B. Ash 8" N 37° W 461k(30.36')

1914, G.H. Johnson  
Set Well Point

#3 Elm 10" N 22° W 24.00'

#4 Elm 12" s 65° W 34.00'

1958, Robert Lunde, M.C.R.C.  
3" Well Point

#5 Maple 10" N 23° W 23.80'

#6 Fence post S 05° W 30.40'

#7 W. Pine 6" NW 90.50'

#9 Fence South 34.50'

#10 R. Pine 4" SW 99.50'

G.M. Blass, Lake Co. Surveyor  
Found 1 1/4" Iron Pipe

#11 W. Pine 8" N 35° W 62.80'

#12 W. Pine 10" N 69° W 90.55'

#13 W. Pine 7" S 60° W 99.80'

#14 Nor. Pine 8" S 08° W 65.08'

B. Description of corner evidence found and/or method applied in restoring or reestablishing corner:

(continued on the back)

M-7 Section corner, Sec's., 13 & 24 on the County Line

On September 23, 1994, I found 1 1/4" Iron Pipe in the center-line of Millerton Road, 0.3' foot below the surface of the Road, did not find any other evidence to disprove the location of the corner. NOTE; did not recover R.A. Griffins 5" x 36" concrete monument, might not have been set.

Condition of recorded witnesses is; #1 Gone #2 Gone #3 Gone #4 gone #5 Gone #6 Gone #7 Found in good #8 Gone #9 Gone #10 Found in good cond. #11 Found in good cond. #12 Same as #7 #13 Same as #10 #14 Found in good cond. #15 Gone #16 Same as #9 #17 Same as #14 #18 Same as #10 #19 Same as #7 #20 Same as #11 #21 Found in good cond. #22 Gone

C. Description of monument for corner and accessories established to perpetuate locating the position of the corner:

M-7 Section corner, Sec's., 13 & 24 on the County Line

Replaced 1 1/4" Iron Pipe with a 5/8" Re-rod 24" in length with a 2 1/2" aluminum cap, Stamped Mason County Monument, 1 foot below road surface, and is accepted as a careful and faithful reestablishment of the position of original corner.

B. Ash 6" N 05° W 47.22' (60d spike in the East side of tree)  
(OBT #17) R. Pine S 10° W 65.05' (brass tag in NW side of tree) 16"  
(OBT #18) R. Pine 13" S 62° W 99.85' (10" dock spike in NW side of tree)  
(OBT #19) W. Pine 20" N 69° W 90.56' (brass tag in NE side of tree)


Signed by Sammy S. Barnett Date 10/4/94

Surveyor's Michigan License No. 16923

Peer Group Reviewed and Approved

Date: 10-5-94

Kenneth L. Ross  
Mason County Surveyor

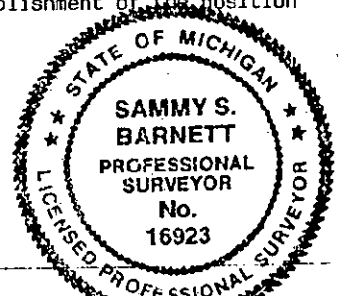

FORM APPROVED BY MICHIGAN STATE BOARD OF LAND SURVEYORS, JAN. 28, 1971  
REVISED MAY 14, 1975  
REVISED JAN., 1983

M-7 Section corner, Sec's., 13 & 24 on the County Line

1965, Robert A. Griffin, P.S. #13584

Replaced Iron Pipe with a 5" squ. concrete monument

- TA**
- #15 Maple 5" N 37° E 60.58'
  - #16 Fence corner post South 34.50'
  - #17 R. Pine 10" S 10° W 65.05'
  - #18 R. Pine 7" S 62° W 99.85'
  - #19 W. Pine 11" N 69° W 90.56'
  - #20 W. Pine 8" N 36° W 62.78'
  - #21 1½" Angle Iron N05° W 32.72'
  - #22 Cedar post 5" x 7' North 33'