

SURVEY & REMONUMENTATION

APR 28 1995

COMMISSION

LAND CORNER RECORDATION CERTIFICATE Filing Requirement of Act 74, Mich. P.A. 1970

For corners in

MASON <small>(County)</small>	Located In:	Corner Code #	
1. Public Land Survey	T 19N R 15W T _____ R _____ T _____ R _____ T _____ R _____	M-8 _____ _____	_____ _____
2. Property Controlling in Section	S _____ T _____ R _____ S _____ T _____ R _____	_____ _____	_____ _____
3. Miscellaneous Property in Sec.	S _____ T _____ R _____ S _____ T _____ R _____	_____ _____	_____ _____

FILED

AT 11:50 O'CLOCK a M

NOV 17 1994

MARY GOLDEN KOLASKI
MASON COUNTY
REGISTER OF DEEDS
Register of Deeds Stamp & File Number

4. Lot No. _____, Recorded Plat _____
 5. Private Claims _____

I, Sammy S. Barnett, in a field survey on November 7, 1994, do hereby certify that under requirements of P.A. 74, Michigan P.A. of 1970, the corner points mentioned in lines 1 and 2 above were in conformance with regulations and rules therefore as required in the current manual of survey instructions of the United States Department of the Interior, Bureau of Land Management or by a decree of a Court of Law and/or that the corner points mentioned in lines 3, 4 and 5 above were in conformance with the rules of the Michigan Board of Land Surveyors or by a Decree of a Court of Law; established, re-established, monumented, re-monumented, recovered, found as expressed below:

	A	B	C	D	E	F	G	H	I	J	K	L	M
2	6		5		4		3		2		1		
3													
4	7		8		9		10		11		12		
5													
6	18		17		16		15		14		13		
7													
8	19		20		21		22		23		24		
9													
10	30		29		28		27		26		25		
11													
12	31		32		33		34		35		36		
13													

NOTE: Not more than 4 corners, all in the same town and range, may be recorded on this certificate.

A. Description of original monument and accessories and/or subsequent restoration:

M-8 1/4 Corner, Section 24, on the Township Line, T19N, R15W.

1838, G.L.O., John Mullette
Set Wood Post

#1 Leynn Wood 8" S 24° W 151k(9.90')
 #2 Birch 4" N 72° W 341k(22.34')
 #3 Stream call North 7.5 Ch. (495')

B. Description of corner evidence found and/or method applied in restoring or reestablishing corner:

M-8 1/4 Corner, Section 24, on the Township Line, T19N, R15W.

On November 7, 1994, I Sammy Barnett and Kevin Pritchard, search for evidence of any corner or witness trees. Due to the remoteness of the area and the lack of any paper history of this corner, I set corner at a single proportional method, being half way and on line between the NE Corner and the SE Corner of Section 24, T19N, R15W. Condition of recorded witnesses is; #1 Gone #2 Gone #3 Measured distance to Little Sable River at 480 + - Due North.


C. Description of monument for corner and accessories established to perpetuate locating the position of the corner:

M-8 1/4 Corner, Section 24, on the Township Line, T19N, R15W.

Set 2 1/2" steel pipe, 36" long, with a brass cap, 3 1/4" in dia., stamped to identify the corner. Corner is accepted as a careful and faithful reestablishment of the position of the original corner.

- B. Ash 6" N 65° W 47.87' (60d spike in SW side of tree)
- B. Ash 8" N 02° W 21.48' (60d spike in SW side of tree)
- B. Ash 4" S 45° E 17.84' (60d spike in NE side of tree)
- B. Ash 4" s 22° W 34.20' (60d spike in SE side of tree)
- G.P.S. Eccentric point (1/2" re-rod with P.S. cap N 88° 16' 04" W 1318.60')

Signed by Sammy S. Barnett Date 11-14-94
 Surveyor's Michigan License No. 16923

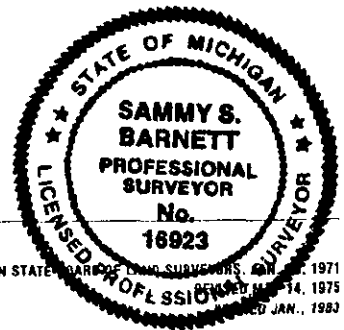

Peer Group Reviewed and Approved
 Date: 11-16-94
 Kenneth L. Ross
 Mason County Surveyor

FORM APPROVED BY MICHIGAN STATE BOARD OF LAND SURVEYORS, 1971
 REVISION JAN., 1975
 REVISION JAN., 1983