

MAR 16 1998

SECTION

LAND CORNER RECORDATION CERTIFICATE
 Filing Requirement of Act 74, Mich. P.A. 1970

For corners in


MASON
 (County)

Located in:

Corner Code --#

- 1. Public Land Survey T 19N R 15W M-8
- T R
- T R
- T R
- 2. Property Controlling S T R
- In Section S T R
- 3. Miscellaneous S T R
- Property in Sec. S T R

Seg 2

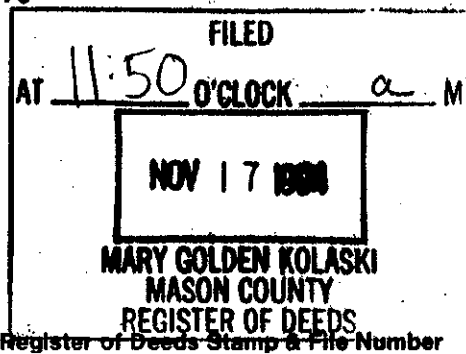

- 4. Lot No. _____, Recorded Plat _____
- 5. Private Claims _____

I, Sammy S. Barnett, in a field survey on November 7, 19 94, do hereby certify that under requirements of P.A. 74, Michigan P.A. of 1970, the corner points mentioned in lines 1 and 2 above were in conformance with regulations and rules therefore as required in the current manual of survey instructions of the United States Department of the Interior, Bureau of Land Management or by a decree of a Court of Law and/or that the corner points mentioned in lines 3, 4 and 5 above were in conformance with the rules of the Michigan Board of Land Surveyors or by a Decree of a Court of Law; established, re-established, monumented, re-monumented, recovered, found as expressed below:

NOTE: Not more than 4 corners, all in the same town and range, may be recorded on this certificate.

A. Description of original monument and accessories and/or subsequent restoration:

M-8 1/4 Corner, Section 24, on the Township Line, T19N, R15W.

1838, G.L.D., John Mullette
 Set Wood Post

- #1 Leynn Wood 8" S 24° W 151k(9.90')
- #2 Birch 4" N 72° W 341k(22.34')
- #3 Stream call North 7.5 Ch. (495')

B. Description of corner evidence found and/or method applied in restoring or reestablishing corner:

M-8 1/4 Corner, Section 24, on the Township Line, T19N, R15W.

On November 7, 1994, I Sammy Barnett and Kevin Pritchard, search for evidence of any corner or witness trees. Due to the remoteness of the area and the lack of any paper history of this corner, I set corner at a single proportional method, being half way and on line between the NE Corner and the SE Corner of Section 24, T19N, R15W. Condition of recorded witnesses is; #1 Gone #2 Gone #3 Measured distance to Little Sable River at 480' + - Due North.

C. Description of monument for corner and accessories established to perpetuate locating the position of the corner:

M-8 1/4 Corner, Section 24, on the Township Line, T19N, R15W.

Set 2 1/2" steel pipe, 36" long, with a brass cap, 3 1/4" in dia., stamped to identify the corner. Corner is accepted as a careful and faithful reestablishment of the position of the original corner.

- B. Ash 6" N 65° W 47.87' (60d spike in SW side of tree)
- B. Ash 8" N 02° W 21.48' (60d spike in SW side of tree)
- B. Ash 4" S 45° E 17.84' (60d spike in NE side of tree)
- B. Ash 4" S 22° W 34.20' (60d spike in SE side of tree)
- G.P.S. Eccentric point (1/2" re-rod with P.S. cap N 88° 16' 04" W 1318.60'

Signed by Sammy S. Barnett

Date 11-14-94

Surveyor's Michigan License No. 16923

Peer Group Reviewed and Approved
 Date: Feb 25 1998
 Kenneth L. Ross
 Mason County Surveyor

Peer Group Reviewed and Approved
 Date: 11-16-94
 Kenneth L. Ross
 Mason County Surveyor

