

# SURVEY & REMONUMENTATION


APR 28 1995

COMMISSION

LAND CORNER RECORDATION CERTIFICATE  
Filing Requirement of Act 74, Mich. P.A. 1970

For corners in

MASON _____ <small>(County)</small>	Located In:	Corner Code #
1. Public Land Survey	T 19 N R 15 W	M-9
	T _____ R _____	_____
	T _____ R _____	_____
	T _____ R _____	_____
2. Property Controlling in Section	S _____ T _____ R _____	_____
	S _____ T _____ R _____	_____
3. Miscellaneous Property in Sec.	S _____ T _____ R _____	_____
	S _____ T _____ R _____	_____

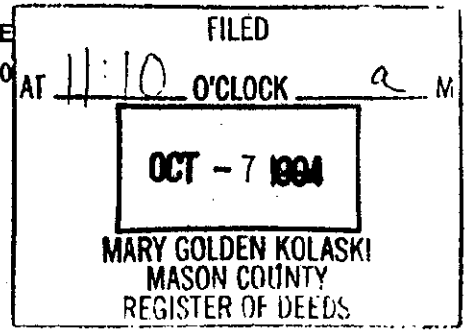

Register of Deeds Stamp & File Number

4. Lot No. \_\_\_\_\_, Recorded Plat \_\_\_\_\_  
5. Private Claims \_\_\_\_\_

	A	B	C	D	E	F	G	H	I	J	K	L	M
2	6	5	4	3	2	1							
3													
4	7	8	9	10	11	12							
5													
6	18	17	16	15	14	13							
7													
8	19	20	21	22	23	24							
9													
10	30	29	28	27	26	25							
11													
12	31	32	33	34	35	36							
13													

I, Sammy S. Barnett, in a field survey on September 20, 19 94, do hereby certify that under requirements of P.A. 74, Michigan P.A. of 1970, the corner points mentioned in lines 1 and 2 above were in conformance with regulations and rules therefore as required in the current manual of survey instructions of the United States Department of the Interior, Bureau of Land Management or by a decree of a Court of Law and/or that the corner points mentioned in lines 3, 4 and 5 above were in conformance with the rules of the Michigan Board of Land Surveyors or by a Decree of a Court of Law; established, re-established, monumented, re-monumented, recovered, found as expressed below:

**NOTE: Not more than 4 corners, all in the same town and range, may be recorded on this certificate.**

A. Description of original monument and accessories and/or subsequent restoration:

M-9 Section corner, Sec's. 24 & 25 on the County Line

<p><u>1838, C.L.O., John Mullett</u> Set wood post</p> <p>#1 Maple 8" S 37° W 341k (22.44') #2 Maple 8" N 03° W 91k ( 5.94') #3 Cor. post 1 ch. (66') North of pond.</p>	<p><u>1914, G. H. Johnson, C.S.</u> <u>Survey Notes</u> Monument not given</p> <p>#4 W. Pine stp. 12" N 65½° W 251k(16.5') #5 B. Oak 12" S 09° E 781k (51.48')</p>
--	--

Undated Survey by G. H. Johnson continued on the back.

B. Description of corner evidence found and/or method applied in restoring or reestablishing corner:

M-9 Section corner, Sec's., 24 & 25 on the County Line

On September 20, 1994, I found U.S.F.S. Concrete Monument 5" squ. x 60" in length with 3" brass cap, monument is 1.5 feet above ground. Condition of recorded witnesses is; #1 Gone #2 Gone #3 Measured 65 feet to the marsh line #4 Found pieces of pine stp. #5 Gone #6 Found pieces of pine stp. #7 Found in good cond. #8 Same as #4 #9 Found in fair cond. #10 Found in good cond. #11 Found in good cond. #12 Found tree is dead #13 Found in good cond. #14 Gone

C. Description of monument for corner and accessories established to perpetuate locating the position of the corner:

M-9 Section corner, Sec's., 24 & 25 on the County Line


Accepted 5" square x 60" concrete monument with 3" dia. brass cap as a substantial marker for the corner, and is accepted as a careful and faithful perpetuation of the position of the original corner.

(OBT #10) Maple 5" N 24° E 28.40' ( 10" dock spike in NW side of tree)  
(OBT #11) B. Oak 16" S 85°-30' E 13.26' (10" dock spike in SW side of tree)  
(OBT #12) W. Oak 9" N 24° W 37.93' ( 10" dock spike in NE side of tree)  
W. Oak 9" N 71° W 10.48' ( 60 d spike in NE side of tree)

Signed by Sammy S. Barnett Date 10/4/94

Surveyor's Michigan License No. 16923

Peer Group Reviewed  
and Approved  
Date: 16 OCT 5 94  
Kenneth L. Ross  
Mason County Surveyor

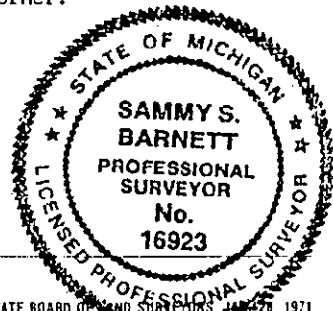

FORM APPROVED BY MICHIGAN STATE BOARD OF SURVEYORS JAN 28, 1971  
REVISED MAY 14, 1975  
REVISED JAN. 1983

M-9 Section corner, Sec's., 24 & 25 on the County Line

continued from the front

- #6 Pine stp. 30" <sup>17</sup> S 81° E 47.00'
- #7 B. Oak 10" S 85° 30' E 12.50'
- #8 Pine stp. 12" N 63° 30' W 17.00'
- #9 Pine stp. 14" N 08° 30' W 27.00'

1965, Robert A. Griffin, P. S. # 13584

Replaced rotted wood stake with a concrete Monument

- #10 Maple 5" N 24° E 28.40'
- #11 B. Oak 16" S 85° 30' E 13.26'
- #12 R. Oak 4" S 36° W 70.17'
- #13 W. Oak 5" N 24° W 37.93'
- #14 Cedar <sup>1</sup>/<sub>2</sub>ost 4"x7' North 1.9'