

**SURVEY &
REMONUMENTATION**

APR 28 1995

COMMISSION

**LAND CORNER RECORDATION CERTIFICATE
Filing Requirement of Act 74, Mich. P.A. 1970**

For corners in

MASON _____ Located In: _____ Corner Code #/

(County)

1. Public Land Survey T 19 N R 15 W M-10
T _____ R _____
T _____ R _____
T _____ R _____
T _____ R _____

2. Property Controlling S _____ T _____ R _____
in Section S _____ T _____ R _____

3. Miscellaneous S _____ T _____ R _____
Property in Sec. S _____ T _____ R _____

Seg-1

FILED
AT 11:10 O'CLOCK a.m. MI

OCT - 7 1994

MARY GOLDEN KOLASKI
MASON COUNTY
REGISTER OF DEEDS

Register of Deeds Stamp & File Number

4. Lot No. _____, Recorded Plat _____
5. Private Claims _____

I, Sammy S. Barnett, in a field survey on _____ September 20, _____, 19 94 _____, do hereby certify that under requirements of P.A. 74, Michigan P.A. of 1970, the corner points mentioned in lines 1 and 2 above were in conformance with regulations and rules therefore as required in the current manual of survey instructions of the United States Department of the Interior, Bureau of Land Management or by a decree of a Court of Law and/or that the corner points mentioned in lines 3, 4 and 5 above were in conformance with the rules of the Michigan Board of Land Surveyors or by a Decree of a Court of Law; established, re-established, monumented, re-monumented, recovered, found as expressed below.

A	B	C	D	E	F	G	H	I	J	K	L	M
2	6	5	4	3	2	1						
3												
4	7	8	9	10	11	12						
5												
6	13	17	16	15	14	13						
7												
8	19	20	21	22	23	24						
9												
10	30	29	28	27	26	25						
11												
12	31	32	33	34	35	36						
13												

NOTE: Not more than 4 corners, all in the same town and range, may be recorded on this certificate.

A. Description of original monument and accessories and/or subsequent restoration:

M-10 East 1/4 corner, Section 25, on the County Line

<u>1838, G.L.O. Jonh Mullett</u> Set wood post	#4 W. Pine stp. 17" S 33° E 27.00'	<u>1965, R.A. Griffin</u> Replaced Well Point with a concrete Monumen
#1 W. Pine 12" S 19° W 101k(6.60')	<u>G.H. Jonhson, undated survey</u> Monument not given	#8 Cedar Post East 1.
#2 Maple 6" N 75° W 521k(34.32')	#5 W. Pine stp. 17" S 88-45' E 51.20'	#9 Maple 5" N65°E 29.1
<u>1914, G.H. Johnson, Lake C.S.</u> Monument not given	#6 W. Oak 6" S 28° E 12.00'	#10 W. Oak 9" S28°E 12.
#3 W. Pine stp. 16" S 86° E 50.00'	#7 W. Oak 7" N 68°-15' W 12.00'	#11 W. Oak 5" S45°W 17.
B. Description of corner evidence found and/or method applied in restoring or reestablishing corner:		#12 W. Oak 9" N68°-15'W 12.40'

M-10 East 1/4 corner, Section 25. on the County Line

On September 20, 1994, I found a 5" square Concrete Monument with Brass cap, set by Robert Griffin, R.L.S. # 13584.

Condition of recorded witnesses is; #1 Gone #2 Gone #3 Gone #4 Gone #5 Gone #6 Found in good cond. #7 Found in good cond. #8 Gone #9 Found in good cond. #10 Same as #6 #11 Found in good cond.

C. Description of monument for corner and accessories established to perpetuate locating the position of the corner:


M-10 East 1/4 corner, Section 25, on the County Line.

Accepted 5" square concrete monument with 3" dia. brass cap as a substantial marker for the corner, and is accepted as a careful and faithful reestablishment of the position of original corner.

- (OBT) #9 Maple 8" N 65° E 29.13' (10" dock spike in North side of tree)
- (OBT) #6 W. Oak 10" S 28° E 12.15' (added 60d spike in NE side of tree)
- (OBT) #11 W. Oak 8" S 45° W 17.64'(10" dock spike in the SE side of tree)
- (OBT) #7 W. Oak 11" N 68°-15' W 12.87'(added 60d spike in SW side of tree)

Signed by Sammy S. Barnett Date 10/4/94

Surveyor's Michigan License No. 16923

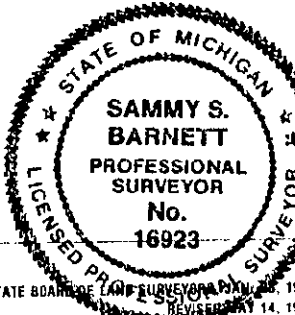

Peer Group Reviewed and Approved
Date: Oct 5-94
Kenneth L. Ross
Mason County Surveyor

FORM APPROVED BY MICHIGAN STATE BOARD OF LAND SURVEYORS, REVISED JAN. 19