

# SURVEY & REMONUMENTATION

APR 28 1995

## COMMISSION

### LAND CORNER RECORDATION CERTIFICATE Filing Requirement of Act 74, Mich. P.A. 1970

For corners in

MASON <small>(County)</small>	Located In:	Corner Code #	
1. Public Land Survey	T 19 N R 15 W	M-11	
	T _____ R _____		
	T _____ R _____		
2. Property Controlling in Section	S _____ T _____		<i>Sec. 1</i>
	S _____ T _____		
3. Miscellaneous Property in Sec.	S _____ T _____		
	S _____ T _____		

FILED

AT 11:10 O'CLOCK a.m.

**OCT - 7 1994**

MARY GOLDEN KOLASKI  
MASON COUNTY  
REGISTER OF DEEDS

**Register of Deeds Stamp & File Number**

4. Lot No. \_\_\_\_\_, Recorded Plat \_\_\_\_\_
5. Private Claims \_\_\_\_\_

I, Sammy S. Barnett, in a field survey on September 20, 1994, do hereby certify that under requirements of P.A. 74, Michigan P.A. of 1970, the corner points mentioned in lines 1 and 2 above were in conformance with regulations and rules therefore as required in the current manual of survey instructions of the United States Department of the Interior, Bureau of Land Management or by a decree of a Court of Law and/or that the corner points mentioned in lines 3, 4 and 5 above were in conformance with the rules of the Michigan Board of Land Surveyors or by a Decree of a Court of Law; established, re-established, monumented, re-monumented, recovered, found as expressed below:

**NOTE: Not more than 4 corners, all in the same town and range, may be recorded on this certificate.**

	A	B	C	D	E	F	G	H	I	J	K	L	M
2	6	5	4	3	2	1							
3													
4	7	8	9	10	11	12							
5													
6	18	17	16	15	14	13							
7													
8	19	20	21	22	23	24							
9													
10	30	29	28	27	26	25							
11													
12	31	32	33	34	35	36							
13													

**A. Description of original monument and accessories and/or subsequent restoration:**

<p>M-11 <u>Section corner, Sec's., 25 &amp; 36 on the County Line</u></p> <p><u>1838, G.L.O., John Mullett</u> Set wood post</p> <p>#1 Birch 8" S 20° W 181k(11.88')</p> <p>#2 Birch 7" N 55° W 121k(7.92')</p>	<p><u>1965, Robert A. Griffin</u> U.S.F.S. tree tag in 7" Cedar</p> <p><u>1972, Ken Stephens</u> Found Iron Pipe No witnesses recorded</p>	<p><u>1991, Robert Wetherell</u> Found 1 1/4" Iron Pipe</p> <p>#3 W. Pine Stp. N35°E 23.80'</p> <p>#4 W. Pine 8" S12°E 23.06'</p> <p>#5 Cedar 6"S65°W 15.21'</p> <p>#6 Cedar 8"S60°E 26.32'</p> <p>#7 W. Pine N18°E 28.90'</p>
---	--	--

**B. Description of corner evidence found and/or method applied in restoring or reestablishing corner:**

M-11 Section corner, Sec's., 25 & 36 on the County Line

On September 23, 1994, I found a 1 1/4" Iron Pipe painted yellow flush with the ground (swamp), also found U.S.F.S. tree tag in Cedar 7" bearing N 25° W 2.20 feet from iron pipe. Condition of recorded witnesses is; #1 Gone #2 Gone #3 Found in fair cond. #4 Found in good cond. #5 Found in good cond. #6 Found in good cond. #7 Found in good cond.

**C. Description of monument for corner and accessories established to perpetuate locating the position of the corner:**

M-11 Section corner, Sec's., 25 & 36 on the County Line

Placed a 5/8" Re-rod with a 2 1/2" Aluminum cap, stamed Mason County Monument inside exiting Iron Pipe for the corner, and is accepted as a careful and faithful reestablishment of the position of the original corner.

(OBT #4) W. Pine 8" S 12° E 23.06' (60d spike in the SW side of tree)


(OBT #5) Cedar 6" S 65° W 15.21' (60d spike in the SE side of tree)

(OBT #6) Cedar 8" S 60° E 26.32" (60d spike in the SW side of tree)

(OBT #7) W. Pine 14" N 18° E 28.90' (60d spike in the SE side of tree)

Signed by Sammy S. Barnett Date 10/4/94

Surveyor's Michigan License No. 16423

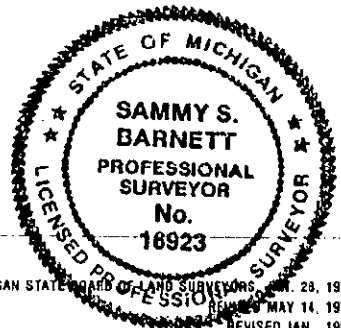

Peer Group Reviewed  
and Approved  
Date: 10-4-94  
Kenneth L. Ross  
Mason County Surveyor