

SURVEY & REMONUMENTATION


APR 28 1995

COMMISSION

For corners in

LAND CORNER RECORDATION CERTIFICATE
Filing Requirement of Act 74, Mich. P.A. 1970

MASON _____ (County)	Located In:	Corner Code #:
1. Public Land Survey	T 19 N R 15 W	M-12
	T _____ R _____	
	T _____ R _____	
	T _____ R _____	
2. Property Controlling in Section	S _____ T _____ R _____	
	S _____ T _____ R _____	
3. Miscellaneous Property in Sec.	S _____ T _____ R _____	
	S _____ T _____ R _____	
4. Lot No. _____, Recorded Plat _____		
5. Private Claims _____		

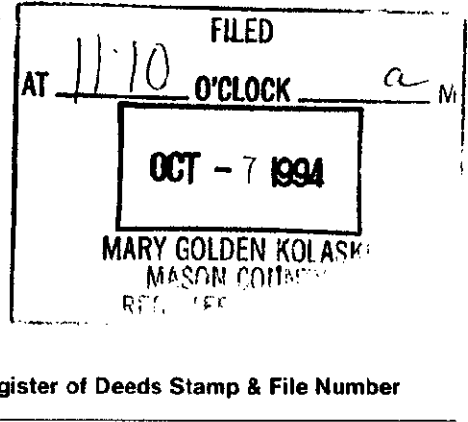

I, Sammy S. Barnett, in a field survey on September 23, 1994, do hereby certify that under requirements of P.A. 74, Michigan P.A. of 1970, the corner points mentioned in lines 1 and 2 above were in conformance with regulations and rules therefore as required in the current manual of survey instructions of the United States Department of the Interior, Bureau of Land Management or by a decree of a Court of Law and/or that the corner points mentioned in lines 3, 4 and 5 above were in conformance with the rules of the Michigan Board of Land Surveyors or by a Decree of a Court of Law; established, re-established, monumented, re-monumented, recovered, found as expressed below:

A	B	C	D	E	F	G	H	I	J	K	L	M
2	6	5	4	3	2	1						
3												
4	7	8	9	10	11	12						
5												
6	18	17	16	15	14	13						
7												
8	19	20	21	22	23	24						
9												
10	30	29	28	27	26	25						
11												
12	31	32	33	34	35	36						
13												

NOTE: Not more than 4 corners, all in the same town and range, may be recorded on this certificate.

A. Description of original monument and accessories and/or subsequent restoration:

M-12 East 1/4 corner, Section 36 on the County Line

1838, G.L.O. John Mullett

Set wood post

#1 Leynn wood 10" S 20° W 91k(5.94')

#2 Cedar 12" N 05° W 151k(9.9')

1991, Robert Wetherell

Set 1/2" Re-rod w/ P.S. cap

inside 3/4" Iron pipe set a equal distant between NE cor. & SE cor. in old fence line 110 feet south of fence running East.

#3 Maple 8" N 20° E 39.78'

#6 Maple 10" S 13° W 58.35'

#4 Maple 4" N 42° W 7.86'

#5 Maple 8" N 88° E 44.53'

B. Description of corner evidence found and/or method applied in restoring or reestablishing corner:

M-12 East 1/4 corner, Section 36 on the County Line

On September 23, 1994, found a 1/2" x 24" inside 3/4" Iron Pipe in old fence line, found no other evidence to dispute this location for the corner. Condition of the recorded witness is; #1 Gone #2 Gone #3 Found in good cond. #4 Found in good cond. #5 Found in good cond. #6 Found in good Cond.

C. Description of monument for corner and accessories established to perpetuate locating the position of the corner:

M-12 East 1/4 corner, Section 36 on the County Line

Placed a 5/8" Re-rod x 24" in length with an aluminum 2 1/2" cap inside exiting 3/4" Iron Pipe, aluminum cap is stamped Mason County Monument, and is accepted as a careful and faithful reestablishment of the position of the original corner.

(OBT #3) Maple 8" N 20° E 39.78' (60d spike in NW side of tree)

(OBT #4) Maple 4" N 42° W 7.86' (60d spike in SW side of tree)


(OBT #5) Maple 8" N 88° E 44.53' (60d spike in North side of tree)

(OBT #6) Maple 10" S 13° W 58.35' (60d spike in NW side of tree)

Signed by Sammy S. Barnett
Surveyor's Michigan License No. 16923

Date 10/4/94

Peer Group Reviewed and Approved
Date: 10-5-94
Kenneth L. Ross
Mason County Surveyor

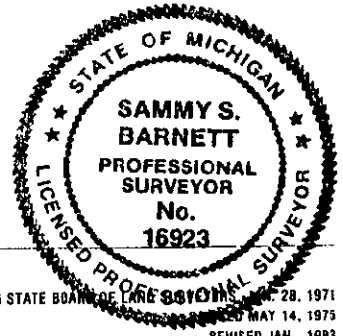

FORM APPROVED BY MICHIGAN STATE BOARD OF LAND SURVEYORS MAY 14, 1973
REVISED JAN., 1983