

**SURVEY & REMONUMENTATION**

MAR 16 1998

**LAND CORNER RECORDATION CERTIFICATE**  
Filing Requirement of Act 74, Mich. P.A. 1970

FILED  
AT 11:10 O'CLOCK a M  
OCT - 7 1994  
MARY GOLDEN KOLASKI  
MASON COUNTY  
REGISTER OF DEEDS  
Register of Deeds Stamp & File Number

SECTION  
For corners in

MASON (County)	Located In:	Corner Code #
1. Public Land Survey	T 19 N R 15 W	M-13
	T R	
	T R	
	T R	
	T R	
2. Property Controlling in Section	S T R	
	S T R	
3. Miscellaneous Property in Sec.	S T R	
	S T R	

A. Lot No. \_\_\_\_\_, Recorded Plat \_\_\_\_\_  
5. Private Claims \_\_\_\_\_

I, Sammy S. Barnett, in a field survey on September 23, 1994, do hereby certify that under requirements of P.A. 74, Michigan P.A. of 1970, the corner points mentioned in lines 1 and 2 above were in conformance with regulations and rules therefore as required in the current manual of survey instructions of the United States Department of the Interior, Bureau of Land Management or by a decree of a Court of Law and/or that the corner points mentioned in lines 3, 4 and 5 above were in conformance with the rules of the Michigan Board of Land Surveyors or by a Decree of a Court of Law; established, re-established, monumented, re-monumented, recovered, found as expressed below:

	A	B	C	D	E	F	G	H	I	J	K	L	M
2	6	5	4	3	2								
3													
4	7	8	9	10	11	12							
5													
6	18	17	16	15	14	13							
7													
8	19	20	21	22	23	24							
9													
10	30	29	28	27	26	25							
11													
12	31	32	33	34	35	36							
13													

NOTE: Not more than 4 corners, all in the same town and range, may be recorded on this certificate.

A. Description of original monument and accessories and/or subsequent restoration:

M-13 SouthEast corner, Section 36, on the County Line

<u>1838, G.L.O., John Mullett</u> Set wood post #1 Beech 16" N 75° W 261k(17.16') #2 Beech 14" N 09° E 481k(31.68')	<u>G.H. Johnson, no date</u> Iron from Survey Notes #3 Elm 10" S23°E 144'	<u>1991, Robert Wetherell, P.S.</u> Found U.S. S. Conc. Mon. #14 Power Pole S 49° E 71.12' #15 Power Pole S 85° W 98.01'
<u>G.H. Johnson, no date, Lake Co. Surveyor, 1916</u> Found remains of old witness trees, set Iron for corner.	<u>G.M. Bless, no date</u> 1" sq. x 12" Iron bar raised with 3/4" x 22" Iron Pipe	#4 Power Pole N 49° E 71.12' (OVER)

B. Description of corner evidence found and/or method applied in restoring or reestablishing corner:

M-13 SouthEast corner, Section 36, on the County Line

On September 23, 1994 found a 5" square x 36" Concrete Monument with 3" brass cap (U.S.F.S.) 1 foot below the gravel Road surface at the intersection of N-S Road & E-W Road. Condition of recorded witnesses is;


#1 Gone #2 Gone #3 Gone #4 Found in good cond. #5 Gone #6 Found NE cor. of conc. slab in fair cond.  
#7 Pole as been replaced #8 Found in good cond. #9 Found in good cond. #10 Same as #5  
#11 Same as #6 #12 Same as #7 #13 Did not find #14 Same as 9 #15 Same as #7

C. Description of monument for corner and accessories established to perpetuate locating the position of the corner:

M-13 SouthEast corner, Section 36, on the County Line

Accepted 5" x 36" Concrete Monument as a substantial marker for the corner, and is accepted as a careful and faithful reestablishment of the position of the original corner.

Power Pole S 48° W 45.51' (60d spike in NW side of pole)  
(OBT #9) Power Pole S 49° E 71.12' ( 16p nail w/ shiner SW side of pole)  
(OBT #7 ) Power Pole S 84° W 98.20' ( 60d spike in NW side of pole)  
) Fence corner post S 55° E 59.30' (60d spike in SW side of post)  
"X" cut in center of grey boulder 6.5' x 3.8' x 1.9' high N 75° E 213.66'

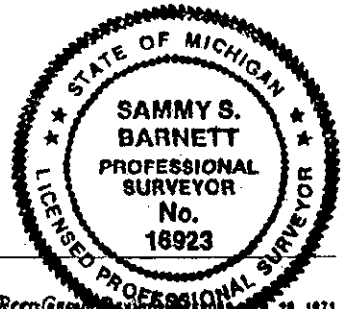

Signed by Sammy S. Barnett Date 10/4/94

Surveyor's Michigan License No. 16923  
Peer Group Reviewed and Approved Date: 10-5-94  
Kenneth L. Ross  
Mason County Surveyor

FORM APPROVED BY MICHIGAN STATE BOARD OF PROFESSIONAL SURVEYORS, REVISED MAY 14, 1975  
Date: Feb 25 1997  
Kenneth L. Ross  
Mason County Surveyor

G. M. Bliss, no date, Lake Co. Surveyor

- #5 Power Pole S 27° W 87.13'
- #6 NE corner of Power Station S 50° W 109.39'
- #7 Power Pole S 85° W 98.05'

1964, Robert A. Griffin, P.S. #13584

Found 1" x 12" square rod and 3/4" x 22" Iron Pipe

Replaced with 5" aqu. x 36" conc. monument w/ brass cap 3"

- #8 "X" cut in top center of a grey boulder 6.5' x 3.8" x 1.9' high
- #9 Power Pole S 49° E 71.12'
- #10 Power Pole S 27° W 87.05'
- #11 NE corner of transformer power station S 50° W 109.44'
- #12 Power Pole S 85° W 98.01'
- #13 Center of brass cap, embedded in conc. post, U.S.G.S. 1143, 1930, Elev. 732 feet N 01° W 64.18'