SURVEY &
REMONUMENTATION

MAR 1 6 1998

SECTION

LAND CORNER RECORDATION CERTIFICATE
Filing Requirement of Act 74, Mich. P.A. 1970

FILED
AT 1:30 O'CLOCK P M
DEC 27 1994
MARY GOLDEN KOLASKI
MASON COUNTY
REGISTER OF DEEDS
Register of Deeds Stamp & File Number

For corners in
MASON (County)

	Located In:	Corner Code #
1. Public Land Survey	T 19N R 15W	K-12
	T ___ R ___	
	T ___ R ___	
	T ___ R ___	Seg. 2
2. Property Controlling	S ___ T ___ R ___	
in Section	S ___ T ___ R ___	
3. Miscellaneous	S ___ T ___ R ___	
Property in Sec.	S ___ T ___ R ___	

4. Lot No. _____, Recorded Plat _____
5. Private Claims _____

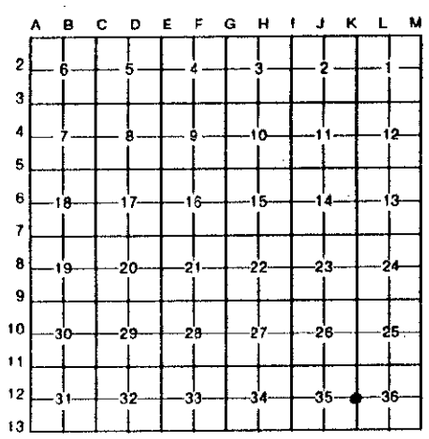

I, John C. Schulke, in a field survey on Nov. 26, 19 94, do hereby certify that under requirements of P.A. 74, Michigan P.A. of 1970, the corner points mentioned in lines 1 and 2 above were in conformance with regulations and rules therefore as required in the current manual of survey instructions of the United States Department of the Interior, Bureau of Land Management or by a decree of a Court of Law and/or that the corner points mentioned in lines 3, 4 and 5 above were in conformance with the rules of the Michigan Board of Land Surveyors or by a Decree of a Court of Law; established, re-established, monumented, re-monumented, recovered, found as expressed below:

NOTE: Not more than 4 corners, all in the same town and range, may be recorded on this certificate.

A. Description of original monument and accessories and/or subsequent restoration:

In 1838, original survey established by Sibley.
Set a wood post at the corner with the following corner references: 10" W Oak N86°E 10 lks.
8" W Oak N56°W 22 lks.

In 1984, D. Dunlap computed the position see LCRC of Liber 2, page 220.

In 1990, Schulke set 1"X30" capped iron pipe. Restored corner by single proportionate measurement as the best available method to reestablish the position of the original corner. The following corner references were blazed and scribed:

18"	Twin W Oak	N35°E	25.72 ft.
12"	W Oak	N61°W	25.40 ft.
11"	R Pine	S74°E	33.28 ft.
15"	R Oak	S66°W	22.72 ft.

ancient fence line running North-South is 14 ft. i
West of the corner.

B. Description of corner evidence found and/or method applied in restoring or reestablishing corner:

Found 1" iron pipe set by J. Schulke from Nordlund & Associates notes in 1979.

STATE OF MICHIGAN
JOHN C. SCHULKE
LAND SURVEYOR
No. 30894
LICENSED LAND SURVEYOR

C. Description of monument for corner and accessories established to perpetuate locating the position of the corner:

Did not accept the pipe and pulled it. Restored corner by single proportionate measurement as the best available method to restablish the position of the original corner. Set 5/8"X3' rebar with a aluminum County Cap to identify the corner with the following corner references:

16"	W Oak	N41°E	26.60 ft.
10"	R Pine	S71°E	33.34 ft.
18"	R Oak	S71°W	22.41 ft.
13"	W Oak	N55°W	25.57 ft.

ancient woven fence running South-North is West 14 ft. of the corner.
6"X6" treated post North 0.7 ft. of the corner.

Peer Group Reviewed and Approved
Date: 12-5-94
Kenneth L. Ross

Signed by John C. Schulke Date 12-05-94
Surveyor's Michigan License No. 30894

Peer Group Reviewed and Approved
Date: 12-5-94
Kenneth L. Ross

FORM APPROVED BY MICHIGAN STATE BOARD OF LAND SURVEYORS, JAN. 28, 1971
REVISED MAY 14, 1975
REVISED JAN., 1983

LIBER 3 PAGE 254