

**SURVEY & REMONUMENTATION**

MAR 16 1998

**LAND CORNER RECORDATION CERTIFICATE**  
 Filing Requirement of Act 74, Mich. P.A. 1970

For corners in SECTION

MASON (County) Located In: Corner Code #

1. Public Land Survey T 19 N R 15 W K-13  
 T R  
 T R  
 T R  
 T R

2. Property Controlling in Section S T R  
 S T R

3. Miscellaneous Property in Sec. S T R  
 S T R

*Sec. 2*

FILED

AT 11:10 O'CLOCK a M

OCT - 7 1994

MARY GOLDEN KOLASKI  
 MASON COUNTY  
 REGISTER OF DEEDS

Register of Deeds Stamp & File Number

4. Lot No. \_\_\_\_\_, Recorded Plat \_\_\_\_\_  
 5. Private Claims \_\_\_\_\_

I, Sammy S. Barnett, in a field survey on September 20, 1994, do hereby certify that under requirements of P.A. 74, Michigan P.A. of 1970, the corner points mentioned in lines 1 and 2 above were in conformance with regulations and rules therefore as required in the current manual of survey instructions of the United States Department of the Interior, Bureau of Land Management or by a decree of a Court of Law and/or that the corner points mentioned in lines 3, 4 and 5 above were in conformance with the rules of the Michigan Board of Land Surveyors or by a Decree of a Court of Law; established, re-established, monumented, re-monumented, recovered, found as expressed below:

**NOTE: Not more than 4 corners, all in the same town and range, may be recorded on this certificate.**

A	B	C	D	E	F	G	H	I	J	K	L	M
2	6	5	4	3	2							
3												
4	7	8	9	10	11	12						
5												
6	18	17	16	15	14	13						
7												
8	19	20	21	22	23	24						
9												
10	30	29	28	27	26	25						
11												
12	31	32	33	34	35	36						
13												

**A. Description of original monument and accessories and/or subsequent restoration:**

K-13 SouthEast corner, Section 35, on the Township Line

1838, G.L.O., John Brink Set wood post  
 #1 Beech 8" N 71° W 331k(21.78')  
 #2 Maple 4" N 35° E 201k(13.20')

1914, C.E. Mitchell Monument - not given

1971, R.A. Griffin, P.S. Did not find corner monument, set by measured distance from NW cor., Sec. 1, T18N, R15W, on a straight line between NE & NW

1990, John Schulke, P.S. Found 10" dock spike, replaced with 1" x 30" iron pipe

R.A. Griffins witnesses  
 #3 Maple 5" N 50° E 100.50'  
 #4 Tw. Maples 10"-10" N 38° 41.45'  
 #5 Center of brass cap monu. NE cor. Sec. 2, T18N, R15W East 14.52'  
 #6 Pine Post 4" x 7' North 33.20'

**B. Description of corner evidence found and/or method applied in restoring or reestablishing corner:**

K-13 SouthEast corner, Section 35, on the Township Line

On September 20, 1994, I found 1" Iron Pipe North of center-line of Decker Road Found no other evidence to disubute this location for the corner.  
 NOTE; Did not recover R.A. Griffins concrete monument, might not have been set.  
 witnesses is; #1 Gone #2 Gone #3 Found in good cond. #4 Found in good cond. #5 Found in good cond. #6 Found in good cond.


**C. Description of monument for corner and accessories established to perpetuate locating the position of the corner:**

K-13 SouthEast corner, Section 35, on the Township Line

Replaced 1" Iron Pipe with a 5/8" Re-rod 24" in lenght with 2 1/2" aluminum cap, stamped Mason County Monument set 1 foot below Road surface, and is accepted as a careful and faithful reestablishment of the position of the original corner.

(OBT #3) Maple 5" N 50° E 100.50' (10" dock in SE side of tree)  
 (OBT #4) Tw. Maple 10"-10" N 38° W 41.45' (10" dock spike in SW side of tree)  
 Center of brass cap concrete monument East 14.50'  
 W Pine 9" N 28° E 48.78' (60d spike in NW side of tree)

Signed by Sammy S. Barnett Date 10/4/94  
 Surveyor's Michigan License No. 16923

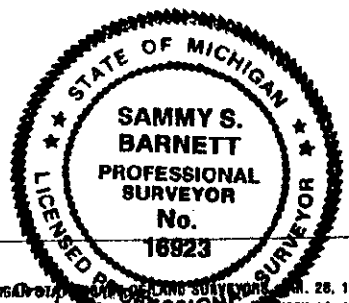

Peer Group Reviewed and Approved Date: 10-5-94  
 Kenneth L. Ross  
 Mason County Surveyor

FORM APPROVED BY MICHIGAN BOARD OF LAND SURVEYORS JAN. 28, 1971 and Approved by PROFESSIONAL SURVEYOR MAY 14, 1975 REVISED JAN., 1983  
 Date: Feb 25 1998  
 Kenneth L. Ross  
 Mason County Surveyor