


SURVEY & REMONUMENTATION

MAR 16 1998

LAND CORNER RECORDATION CERTIFICATE
 Filing Requirement of Act 74, Mich. P.A. 1970

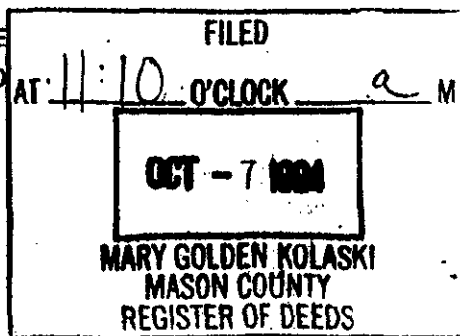

SECTION
 For corners in

MASON (County)
 Located In: Corner Code #
 1. Public Land Survey T 19 N R 15 W M-9
 T R
 T R
 T R
 2. Property Controlling S T R
 in Section S T R
 3. Miscellaneous S T R
 Property in Sec. S T R

4. Lot No. _____, Recorded Plat _____
 5. Private Claims _____

I, Sammy S. Barnett, in a field survey on September 20, 19 94, do hereby certify that under requirements of P.A. 74, Michigan P.A. of 1970, the corner points mentioned in lines 1 and 2 above were in conformance with regulations and rules therefore as required in the current manual of survey instructions of the United States Department of the Interior, Bureau of Land Management or by a decree of a Court of Law and/or that the corner points mentioned in lines 3, 4 and 5 above were in conformance with the rules of the Michigan Board of Land Surveyors or by a Decree of a Court of Law; established, re-established, monumented, re-monumented, recovered, found as expressed below:

NOTE: Not more than 4 corners, all in the same town and range, may be recorded on this certificate.

	A	B	C	D	E	F	G	H	I	J	K	L	M
2	6	5	4	3	2	1							
3													
4	7	8	9	10	11	12							
5													
6	18	17	16	15	14	13							
7													
8	19	20	21	22	23	24							
9													
10	30	29	28	27	26	25							
11													
12	31	32	33	34	35	36							
13													

A. Description of original monument and accessories and/or subsequent restoration:

M-9 Section corner, Sec's. 24 & 25 on the County Line
1838, G.L.O., John Mullett 1914, G. H. Johnson, C.S.
Set wood post Survey Notes
 #1 Maple 8" S 37° W 341k (22.44') Monument not given
 #2 Maple 8" N 03° W 91k (5.94') #4 W. Pine stp. 12" N 65½° W 251k(16.5')
 #3 Cor. post 1 ch. (66') North of pond. #5 B. Oak 12" S 09° E 781k (51.48')


Undated Survey by G. H. Johnson continued on the back.

B. Description of corner evidence found and/or method applied in restoring or reestablishing corner:

M-9 Section corner, Sec's., 24 & 25 on the County Line
 On September 20, 1994, I found U.S.F.S. Concrete Monument 5" squ. x 60" in length with 3" brass cap, monument is 1.5 feet above ground. Condition of recorded witnesses is; #1 Gone #2 Gone #3 Measured 65 feet to the marsh line #4 Found pieces of pine stp. #5 Gone #6 Found pieces of pine stp. #7 Found in good cond. #8 Same as #4 #9 Found in fair cond. #10 Found in good cond. #11 Found in good cond. #12 Found tree is dead #13 Found in good cond. #14 Gone

C. Description of monument for corner and accessories established to perpetuate locating the position of the corner:

M-9 Section corner, Sec's., 24 & 25 on the County Line
 Accepted 5" square x 60" concrete monument with 3" dia. brass cap as a substantial marker for the corner, and is accepted as a careful and faithful perpetuation of the position of the original corner.
 (DBT #10) Maple 5" N 24° E 28.40' (10" dock spike in NW side of tree)
 (DBT #11) B. Oak 16" S 85°-30' E 13.26' (10" dock spike in SW side of tree)
 (DBT #12) W. Oak 9" N 24° W 37.93' (10" dock spike in NE side of tree)
 W. Oak 9" N 71° W 10.48' (60 d spike in NE side of tree)

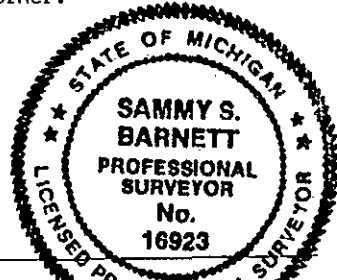

Signed by Sammy S. Barnett
 Surveyor's Michigan License No. 16923

Date 10/4/94

Peer Group Reviewed and Approved
 Date: 10 OCT 5-94
 Kenneth L. Ross
 Mason County Surveyor

FORM APPROVED BY MICHIGAN STATE BOARD OF SURVEYORS
 Date: FEB 25 1995
 Kenneth L. Ross
 Mason County Surveyor