


SURVEY & REMONUMENTATION

MAR 16 1998

LAND CORNER RECORDATION CERTIFICATE
 Filing Requirement of Act 74, Mich. P.A. 1970

For corners in SECTION

<u>MASON</u> (County)	Located In:	Corner Code #
1. Public Land Survey	T 19 N R 15 W	M-10
	T _____ R _____	
	T _____ R _____	
	T _____ R _____	
2. Property Controlling in Section	S _____ T _____ R _____	<i>Seg 2</i>
	S _____ T _____ R _____	
3. Miscellaneous Property in Sec.	S _____ T _____ R _____	
	S _____ T _____ R _____	

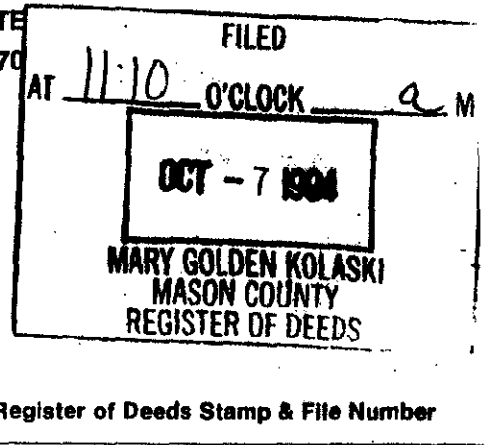

4. Lot No. _____, Recorded Plat _____
 5. Private Claims _____

I, Sammy S. Barnett in a field survey on September 20, 1994 do hereby certify that under requirements of P.A. 74, Michigan P.A. of 1970, the corner points mentioned in lines 1 and 2 above were in conformance with regulations and rules therefore as required in the current manual of survey instructions of the United States Department of the Interior, Bureau of Land Management or by a decree of a Court of Law and/or that the corner points mentioned in lines 3, 4 and 5 above were in conformance with the rules of the Michigan Board of Land Surveyors or by a Decree of a Court of Law; established, re-established, monumented, re-monumented, recovered, found as expressed below:

A	B	C	D	E	F	G	H	I	J	K	L	M
2	6	5	4	3	2	1						
3												
4	7	8	9	10	11	12						
5												
6	16	17	16	15	14	13						
7												
8	19	20	21	22	23	24						
9												
10	30	29	28	27	26	25						
11												
12	31	32	33	34	35	36						
13												

NOTE: Not more than 4 corners, all in the same town and range, may be recorded on this certificate.

A. Description of original monument and accessories and/or subsequent restoration:

M-10 East 1/4 corner, Section 25, on the County Line

1838, G.L.O. Jonh Mullett
Set wood post

#4 W. Pine stp. 17" S 33° E 27.00'

1965, R.A. Griffin
Replaced Well Point with a concrete Monument

#1 W. Pine 12" S 19° W 101k(6.60')

G.H. Jonhson, undated survey
Monument not given

#8 Cedar Post East 1.6

#2 Maple 6" N 75° W 521k(34.32')

#5 W. Pine stp. 17" S 88-45° E 51.20'

#9 Maple 5" N65°E 29.13

1914, G.H. Johnson, Lake C.S.

#6 W. Oak 6" S 28° E 12.00'

#10 W. Oak 9" S28°E 12.0

Monument not given

#7 W. Oak 7" N 68°-15' W 12.00'

#11 W. Oak 5" S45°W 17.6

#3 W. Pine stp. 16" S 86° E 50.00'

#12 W. Oak 9" N68°-15'W 12.40'

B. Description of corner evidence found and/or method applied in restoring or reestablishing corner:

M-10 East 1/4 corner, Section 25. on the County Line

On September 20, 1994, I found a 5" square Concrete Monument with Brass cap, set by Robert Griffin, R.L.S. # 13584.

Condition of recorded witnesses is; #1 Gone #2 Gone #3 Gone #4 Gone #5 Gone #6 Found in good cond. #7 Found in good cond. #8 Gone #9 Found in good cond. #10 Same as #6 #11 Found in good cond.

C. Description of monument for corner and accessories established to perpetuate locating the position of the corner:

M-10 East 1/4 corner, Section 25, on the County Line


Accepted 5" square concrete monument with 3" dia. brass cap as a substantial marker for the corner, and is accepted as a careful and faithful reestablishment of the position of original corner.

- (OBT) #9 Maple 8" N 65° E 29.13' (10" dock spike in North side of tree)
- (OBT) #6 W. Oak 10" S 28° E 12.15' (added 60d spike in NE side of tree)
- (OBT) #11 W. Oak 8" S 45° W 17.64' (10" dock spike in the SE side of tree)
- (OBT) #7 W. Oak 11" N 68°-15' W 12.87' (added 60d spike in SW side of tree)

Signed by Sammy S. Barnett Date 10/4/94

Surveyor's Michigan License No. 16923

Peer Group Reviewed and Approved
 Date: Oct 5-94
Kenneth L. Ross
 Mason County Surveyor

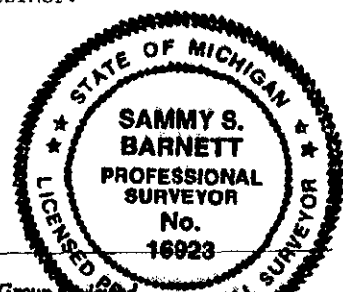

FORM APPROVED BY MICHIGAN STATE BOARD OF LAND SURVEYORS, 1971
