

SURVEY & REMONUMENTATION

MAR 16 1998

LAND CORNER RECORDATION CERTIFICATE
Filing Requirement of Act 74, Mich. P.A. 1970

FILED
AT 11:10 O'CLOCK a M
OCT - 7 1994
MARY GOLDEN KOLASKI
MASON COUNTY
REGISTER OF DEEDS
Register of Deeds Stamp & File Number

SECTION
For corners in

MASON (County)	Located In:	Corner Code ##
1. Public Land Survey	T 19 N R 15 W	M-13
	T R	
	T R	
	T R	
2. Property Controlling in Section	S T R	
	S T R	
3. Miscellaneous Property in Sec.	S T R	
	S T R	

A. Lot No. _____, Recorded Plat _____
5. Private Claims _____

I, Sammy S. Barnett, in a field survey on September 23, 1994, do hereby certify that under requirements of P.A. 74, Michigan P.A. of 1970, the corner points mentioned in lines 1 and 2 above were in conformance with regulations and rules therefore as required in the current manual of survey instructions of the United States Department of the Interior, Bureau of Land Management or by a decree of a Court of Law and/or that the corner points mentioned in lines 3, 4 and 5 above were in conformance with the rules of the Michigan Board of Land Surveyors or by a Decree of a Court of Law; established, re-established, monumented, re-monumented, recovered, found as expressed below:

	A	B	C	D	E	F	G	H	I	J	K	L	M
2	6	5	4	3	2								
3													
4	7	8	9	10	11	12							
5													
6	13	17	16	15	14	13							
7													
8	19	20	21	22	23	24							
9													
10	30	29	28	27	26	25							
11													
12	31	32	33	34	35	36							
13													

NOTE: Not more than 4 corners, all in the same town and range, may be recorded on this certificate.

A. Description of original monument and accessories and/or subsequent restoration:

M-13 SouthEast corner, Section 36, on the County Line

<u>1838, G.L.O., John Mullett</u> Set wood post #1 Beech 16" N 75° W 261k(17.16') #2 Beech 14" N 09° E 481k(31.68')	<u>G.H. Johnson, no date</u> Iron from Survey Notes #3 Elm 10" S23°E 144'	<u>1991, Robert Wetherell, P.S.</u> Found U.S.F.S. Conc. Mon. #14 Power Pole S 49° E 71.12' #15 Power Pole S 85° W 98.01'
<u>G.H. Johnson, no date, Lake Co. Surveyor, 1916</u> Found remains of old witness trees, set Iron for corner.	<u>G.M. Bless, no date</u> 1" sq. x 12" Iron bar raised with 3/4" x 22" Iron Pipe	#4 Power Pole N 49° E 71.12' (OVER)

B. Description of corner evidence found and/or method applied in restoring or reestablishing corner:

M-13 SouthEast corner, Section 36, on the County Line

On September 23, 1994 found a 5" square x 36" Concrete Monument with 3" brass cap (U.S.F.S.) 1 foot below the gravel Road surface at the intersection of N-S Road & E-W Road. Condition of recorded witnesses is;

#1 Gone	#2 Gone	#3 Gone	#4 Found in good cond.	#5 Gone	#6 Found NE cor. of conc. slab in fair cond.
#7 Pole as been replaced	#8 Found in good cond.	#9 Found in good cond.	#10 Same as #5		
#11 Same as #6	#12 Same as #7	#13 Did not find	#14 Same as 9	#15 Same as #7	


C. Description of monument for corner and accessories established to perpetuate locating the position of the corner:

M-13 SouthEast corner, Section 36, on the County Line

Accepted 5" x 36" Concrete Monument as a substantial marker for the corner, and is accepted as a careful and faithful reestablishment of the position of the original corner.

- Power Pole S 48° W 45.51' (60d spike in NW side of pole)
- (OBT #9) Power Pole S 49° E 71.12' (16p nail w/ shiner SW side of pole)
- (OBT #7) Power Pole S 84° W 98.20' (60d spike in NW side of pole)
-) Fence corner post S 55° E 59.30' (60d spike in SW side of post)
- "X" cut in center of grey boulder 6.5' x 3.8' x 1.9' high N 75° E 213.66'

Signed by Sammy S. Barnett Date 10/4/94
Surveyor's Michigan License No. 16923

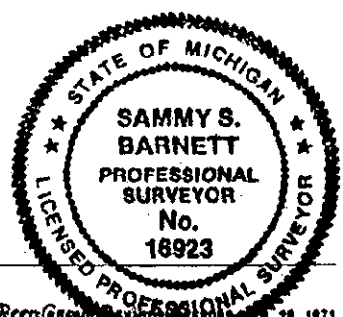

Peer Group Reviewed and Approved Date: 10-5-94
Kenneth L. Ross
Mason County Surveyor

FORM APPROVED BY MICHIGAN STATE BOARD OF PROFESSIONAL SURVEYORS, REVISED MAY 14, 1975
Date: Feb 25 1997
Kenneth L. Ross
Mason County Surveyor