SURVEY &
REMONUMENTATION

MAR 1 6 1998

SECTION

LAND CORNER RECORDATION CERTIFICATE

Filing Requirement of Act 74, Mich. P.A. 1970

FILED
AT 2:45 O'CLOCK p M
DEC 2 2 1994
MARY GOLDEN KOLASKI
MASON COUNTY
REGISTER OF DEEDS

Register of Deeds Stamp & File Number

For corners in MASON (County)

	Located In:	Corner Code ##
1. Public Land Survey	T 19 N R 15 W	L-7
	T ___ R ___	
	T ___ R ___	
	T ___ R ___	Leg. 2
2. Property Controlling	S ___ T ___ R ___	
in Section	S ___ T ___ R ___	
3. Miscellaneous	S ___ T ___ R ___	
Property in Sec.	S ___ T ___ R ___	

4. Lot No. _____ , Recorded Plat _____
5. Private Claims _____

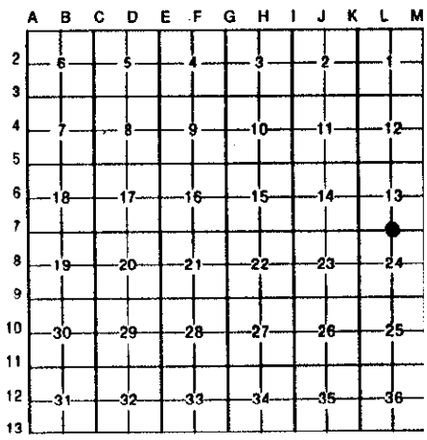

I, Sammy S. Barnett, in a field survey on October, 19 94, do hereby certify that under requirements of P.A. 74, Michigan P.A. of 1970, the corner points mentioned in lines 1 and 2 above were in conformance with regulations and rules therefore as required in the current manual of survey instructions of the United States Department of the Interior, Bureau of Land Management or by a decree of a Court of Law and/or that the corner points mentioned in lines 3, 4 and 5 above were in conformance with the rules of the Michigan Board of Land Surveyors or by a Decree of a Court of Law; established, re-established, monumented, re-monumented, recovered, found as expressed below:

NOTE: Not more than 4 corners, all in the same town and range, may be recorded on this certificate.

A. Description of original monument and accessories and/or subsequent restoration:

L-7 1/4 corner for Sections 13 & 24, T19N, R15W

1838, G.L.O., Slyvester Sibley
Set Wood Stake
#1 W. Oak 8" N 69° E 181k(11.88')
#2 W. Oak 8" S 51° W 71k(4.62')

1958, M.C.R.C.
Found Wood Stake & Iron
#3 Elm 24" NE 53.0'
#4 Elm 14" SE 118.6'
#5 Elm 10" SW 39.51'
#6 Maple Clp. 6" NW 68.5'
#7 1/2 Iron Pipe South 33.0'

1970, J. Borsfay M C R C
Found Wood Stake & Large Iron
Set 3/4" x 24" Iron Rod
#8 Maple Clp. 8" NW 68.36'
#9 Tw. Maple 30" NE 79.03'
#10 W. Ash 14" SW 39.82'
#11 Tw. Birch 10" South 58.81'
#12 1/2" Iron Pipe South 33.00'

B. Description of corner evidence found and/or method applied in restoring or reestablishing corner:

L-7 1/4 corner for Sections 13 & 24, T19N, R15W

On October 24, 1994, I found a 1/2" Re-Rod with RLS cap marked N/A, carefully removed Re-Rod to dig for J. Borsfa 3/4" Iron Rod & Wood Stake, but could not find, we then check RE-Rod location from recorded witnesses we located, position of the Re-Rod fit record distances & bearing of found trees, accepted RE-Rod as a good reestablishment of J. Borsfay corner.
Condition of recorded witnesses is; #1 Gone #2 Gone #3 Gone #4 Found Stump in poor cond. #5 Gone #6 Found One tree #7 Found in good cond. #8 Same as 6 #9 Found in good cond. #10 Gone #11 Found Stump in poor cond. #12 Same as 7.

Peer Group Reviewed and Approved
Date: 12-5-94
Kenneth L. Ross
Mason County Surveyor

C. Description of monument for corner and accessories established to perpetuate locating the position of the corner:

L-7 1/4 corner for Sections 13 & 24, T19N, R15W

Replaced 1/2" Re-Rod with a 5/8" x 24" Re-Rod with an 21/2" aluminum cap, stamp MASON COUNTY MONUMENT, set 1 foot below gravel road surface, and is a careful and faithful reestablishment of the position of the original corner.

(OBT #9) Twin Maple 36" N 38 E 79.03' (60d spike in SE side of tree.)
Elm 6" N 30° W 50.88' (60d spike in SW side of tree.)
Cedar 6" S 58° W 79.91' (60d spike in NW side of tree.)
1/2" Iron Pipe South 33.00'

STATE OF MICHIGAN
SAMMY S. BARNETT
PROFESSIONAL SURVEYOR
No. 16923
LICENSED PROFESSIONAL SURVEYOR

Signed by Sammy S Barnett Date 11-14-94

Surveyor's Michigan License No. 16923

FORM APPROVED BY MICHIGAN STATE BOARD OF LAND SURVEYORS JAN. 28, 197
REVISED MAY 14, 197
REVISED JAN., 198

Peer Group Reviewed and Approved
Date: 12-5-94
Kenneth L. Ross
Mason County Surveyor

LIBER 3 PAGE 244