

SURVEY & REMONUMENTATION


MAR 16 1998

SECTION

LAND CORNER RECORDATION CERTIFICATE
Filing Requirement of Act 74, Mich. P.A. 1970

For corners in

<u>MASON</u> (County)	Located In:	Corner Code #:
1. Public Land Survey	T 19N R 15W	I-10
	T _____ R _____	
	T _____ R _____	
	T _____ R _____	
2. Property Controlling in Section	S _____ T _____ R _____	<i>Sec-2</i>
	S _____ T _____ R _____	
3. Miscellaneous Property in Sec.	S _____ T _____ R _____	
	S _____ T _____ R _____	

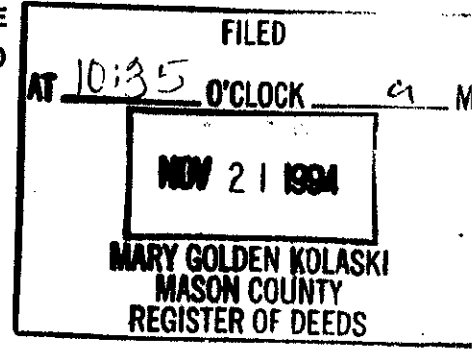

Register of Deeds Stamp & File Number

4. Lot No. _____, Recorded Plat _____
5. Private Claims _____

A	B	C	D	E	F	G	H	I	J	K	L	M
2	6	5	4	3	2	1						
3												
4	7	8	9	10	11	12						
5												
6	18	17	16	15	14	13						
7												
8	19	20	21	22	23	24						
9												
10	30	29	28	27	26	25						
11												
12	31	32	33	34	35	36						
13												

I, John Schulke, in a field survey on Nov. 5th, 1994, do hereby certify that under requirements of P.A. 74, Michigan P.A. of 1970, the corner points mentioned in lines 1 and 2 above were in conformance with regulations and rules therefore as required in the current manual of survey instructions of the United States Department of the Interior, Bureau of Land Management or by a decree of a Court of Law and/or that the corner points mentioned in lines 3, 4 and 5 above were in conformance with the rules of the Michigan Board of Land Surveyors or by a Decree of a Court of Law; established, re-established, monumented, re-monumented, recovered, found as expressed below:

NOTE: Not more than 4 corners, all in the same town and range, may be recorded on this certificate.

A. Description of original monument and accessories and/or subsequent restoration:


Original survey established in 1838 by Sibley.
Set a wooden post with the following references:
1. W. Oak 36" N55°W 10 lks.
2. Beech 8" S43°E 11 lks.

In 1984, D. Dunlap indicated he found 1" pipe at the corner. He Reset 1/2" pipe from ties. The following corner references (see Liber 2, page 218):
6. Spike in E. Face of 22" B Oak N15°W 78.20 ft.
7. Spike in S. Face of 24" B Oak S81°W 34.15 ft.
8. Spike in NW face of 24" B Oak S25°W 81.25 ft.
9. 1/2"X24" iron bar N88°29'48"E 33.00 ft.

Undated, Mason Co. Rd. Comm. noted 1" iron pipe as the monument with the following references:
3. Blk. Oak 12" N19°W 78.2 ft.
4. R Oak 15" S81°W 33.4 ft.
5. W Oak 4" S88°E 37.9 ft.

B. Description of corner evidence found and/or method applied in restoring or reestablishing corner:

Found 1/2"X24" iron pipe (1" below the surface of Taylor road). Center line of road 6 ft. West. Note: area had been cut at one time for road reconstruction. References 1, 2, 4 & 5 are gone. References 3 and 6 same tree-recovered. Reference #7-gone. Reference #8-recovered

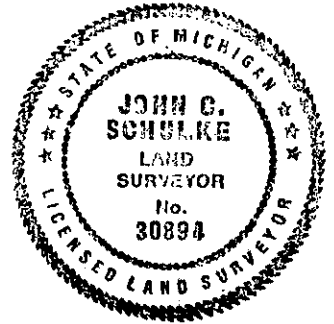

C. Description of monument for corner and accessories established to perpetuate locating the position of the corner:

Replaced 1/2" iron pipe with 5/8"X2" iron rered with an aluminum cap monument stamped to identify the corner (1 1/2" below the surface of Taylor road). Center line of road 6 ft. West. The following corner references:
R Oak 34" N10°W 78.29 ft. (Fd. nail & blazed)
W Oak 10" S81°E 46.46 ft. (blazed)
W Oak twin 10" S28°E 47.44 ft. (blazed)
Clump
R Maple 10" N33°E 63.50 ft. (Southerly tree trunk)
W Oak 6" S82°W 81.7 ft. (no nail or blazed)

Peer Group Reviewed and Approved
Date: Feb 24, 1998
Kenneth L. Ross
Kenneth L. Ross
Mason County Surveyor

(NOTE: Corner is accepted as the best evidence of the perpetuated location of the original corner).

Signed by John C Schulke Date Nov 7, 1994
Surveyor's Michigan License No. PLS-30894