

**SURVEY & REMONUMENTATION**

MAR 16 1998


**LAND CORNER RECORDATION CERTIFICATE**  
Filing Requirement of Act 74, Mich. P.A. 1970

For corners in SECTION  
MASON  
(County)

Located In: Corner Code #

- 1. Public Land Survey T 19 N R 15 W J-13  
T R  
T R  
T R  
T R
- 2. Property Controlling S T R  
in Section S T R
- 3. Miscellaneous S T R  
Property in Sec. S T R

*Seg-2*

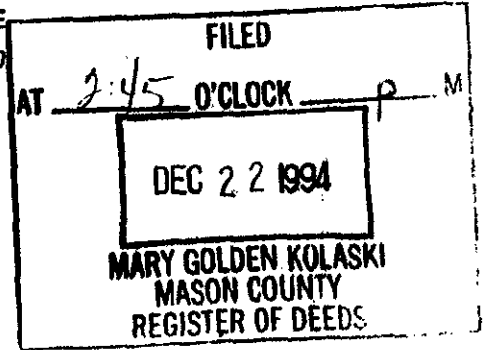

Register of Deeds Stamp & File Number

- 4. Lot No. \_\_\_\_\_, Recorded Plat \_\_\_\_\_
- 5. Private Claims \_\_\_\_\_

	A	B	C	D	E	F	G	H	I	J	K	L	M
2	6	5	4	3	2								
3													
4	7	8	9	10	11	12							
5													
6	18	17	16	15	14	13							
7													
8	19	20	21	22	23	24							
9													
10	30	29	28	27	26	25							
11													
12	31	32	33	34	35	36							
13													

I, Sammy S. Barnett, in a field survey on October, 1994, do hereby certify that under requirements of P.A. 74, Michigan P.A. of 1970, the corner points mentioned in lines 1 and 2 above were in conformance with regulations and rules therefore as required in the current manual of survey instructions of the United States Department of the Interior, Bureau of Land Management or by a decree of a Court of Law and/or that the corner points mentioned in lines 3, 4 and 5 above were in conformance with the rules of the Michigan Board of Land Surveyors or by a Decree of a Court of Law; established, re-established, monumented, re-monumented, recovered, found as expressed below:

**NOTE: Not more than 4 corners, all in the same town and range, may be recorded on this certificate.**

A. Description of original monument and accessories and/or subsequent restoration:

- J-13 South 1/4 corner for Section 35, T19N, R15W, on the township line.  

<u>1838, G.L.O., John Mulette</u> Set Wood Post	<u>1968, K.B. Stephens, RLS # 7318</u> Set 1" Iron Pipe
#1 Beech 8" N 56° W 231k(15.18')	#3 Tw. Oak 10" & 4" NNW 33.52'
#2 Beech 7" N 30° E 321k(21.12')	#4 Tw. B. Oak 12" NNW 55.08'
	#5 Closing corner 18.53' East

J. Schulke, PS # 30894  
In 1990 could not locate any marker for corner, so re-set 1" Iron Pipe from record distance from survey of Dennis Dunlap, L270, P768, 2645.48' from SW Cor.  
#6 W. Oak 14" N08°W 33.57'  
#7 B. Oak 12" S16° E 89.90'  
#8 1/2" Re-Rod P.S. cap N02°E 33.06'


B. Description of corner evidence found and/or method applied in restoring or reestablishing corner:

- J-13 South 1/4 corner for Section 35, T19N, R15W, on the township line.  
On October 20, 1994, I found 1" Iron Pipe in center of Decker Road, and found no conflicting evidence to disubted its location.  
Condition of recored witnesses is; #1 Gone #2 Gone #3 Gone #4 Found in good cond. #5 Measured 18.07 feet #6 Found in good cond. #7 Found in good cond. #8 Found in good cond.

C. Description of monument for corner and accessories established to perpetuate locating the position of the corner:

- J-13 South 1/4 corner for Section 35, T19N, R15W, on the township line.  
Replaced 1" Iron Pipe with a 5/8" x 24" Re-Rod with 2 1/2" aluminum cap, stamp MASON COUNTY MONUMENT, set 1 foot below gravel road surface, and is a careful and faithful reestablishment of the position of the original corner.  
Twin Black Oak 16"-16" N 43° W 44.62' ( 60d spike in SW side of tree.)  
(OBT #6) W. Oak 15" N 10° W 33.57' (60d spike in NE side of trec)  
(OBT #7) B. Oak 15" S 18° E 89.78' (60d spike in NE side of tree)  
1/2" Re-Rod PS cap # 21759 N 02° E 33.06'

Signed by Sammy S. Barnett Date 11-16-94  
Surveyor's Michigan License No. 16923

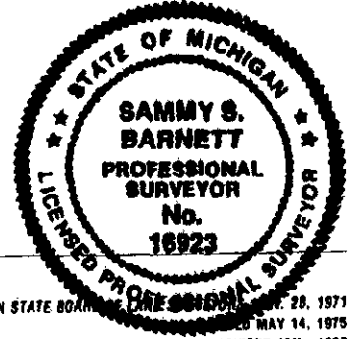

Peer Group Reviewed and Approved  
Date: 12-5-94  
Kenneth L. Foss  
Mason County Surveyor

FORM APPROVED BY MICHIGAN STATE BOARD OF SURVEYORS, MAY 14, 1975  
REVISED JAN., 1983