

LAND CORNER RECORDATION CERTIFICATE
Filing Requirement of Act 74, Mich. P.A. 1970


For corners in

MASON (County) Located In: _____ Corner Code: # _____

1. Public Land Survey T 19N R 15W I-11
 T _____ R _____
 T _____ R _____
 T _____ R _____

2. Property Controlling S _____ T _____ R _____
 In Section S _____ T _____ R _____

3. Miscellaneous S _____ T _____ R _____
 Property in Sec. S _____ T _____ R _____

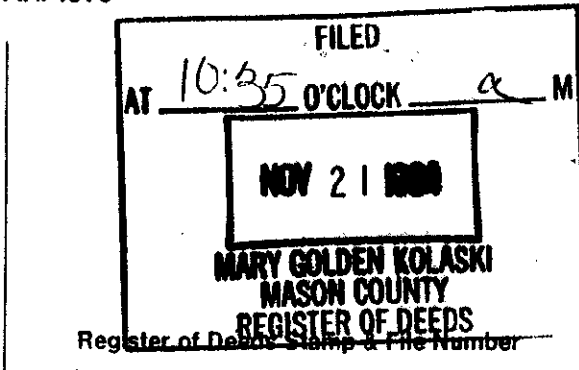

4. Lot No. _____, Recorded Plat _____
 5. Private Claims _____

	A	B	C	D	E	F	G	H	I	J	K	L	M
2	6	5	4	3	2	1							
3													
4	7	8	9	10	11	12							
5													
6	18	17	16	15	14	13							
7													
8	19	20	21	22	23	24							
9													
10	30	29	28	27	26	25							
11													
12	31	32	33	34	35	36							

I, John Schulke, in a field survey on Nov. 5th, 19 94, do hereby certify that under requirements of P.A. 74, Michigan P.A. of 1970, the corner points mentioned in lines 1 and 2 above were in conformance with regulations and rules therefore as required in the current manual of survey instructions of the United States Department of the Interior, Bureau of Land Management or by a decree of a Court of Law and/or that the corner points mentioned in lines 3, 4 and 5 above were in conformance with the rules of the Michigan Board of Land Surveyors or by a Decree of a Court of Law; established, re-established, monumented, re-monumented, recovered, found as expressed below:

NOTE: Not more than 4 corners, all in the same town and range, may be recorded on this certificate.

A. Description of original monument and accessories and/or subsequent restoration:

Original survey established in 1838 by Sibley.
 Set a wooden post with the following references:
 1. Beech 12" S15°W 26 lks.
 2. Maple 12" N32°E 22 lks.

In 1896, J.W. Griswold (see Book 1, Page 309) found corner set by Eastman, no references.
 3. North 1/4 corner of Section 34 West 2633.4 ft.
 4. East 1/4 corner of Section 34 South 2566.7 ft.

In 1971, Ross shows an 1" iron pipe at the corner.
 6. Tel. pole S15°W 84.60 ft.
 7. Power pole S25°E 94.20 ft.

In 1938, Survey by Lunde found 1 1/4" iron pipe and also a stone, said post being 32 ft. East and 33.4 ft. North of a corner steel fence post.
 5. East 1/4 corner of Section 34 established S1°E 2566.0 ft.

In 1984, D. Dunlap indicated he found iron (see corner certificate Liber 2, page 224).

B. Description of corner evidence found and/or method applied in restoring or reestablishing corner:

Recovered 1 1/4" iron pipe, stone on North side and on center line of Taylor and Sugar Grove Roads. Also found 1" iron pipe N34°21'E a distance of 3.62 ft.
 References #1, 2, 5, 6 and 7 not recovered
 North 1/4 corner of Section 34 N87°10'26"W (Grid bearing) 2633.83 ft.
 East 1/4 corner of Section 34 S0°53'00"W 2565.22 ft. (Grid-Bearing & Distances)
 Southeast corner of Section 34 S0°53'13"W 5131.20 ft.

SURVEY & REMONUMENTATION
MAR 16 1998
SECTION



C. Description of monument for corner and accessories established to perpetuate locating the position of the corner:

Set 5/8" X2' rerod inside the 1 1/4" iron pipe with an aluminum cap monument stamped to identify the corner. The monument 10 inches below the surface of the road. The following corner references:

Power pole	N14°W	96.31 ft.
Power pole	N20°E	88.12 ft.
Apple 6"	S60°E	40.99 ft.
Road sign	S69°W	42.3 ft.
6"X6" treated wood post	N48°E	50.35 ft.
6"X6" treated wood post	N87°E	36.94 ft.

Peer Group Reviewed and Approved
 Date: Nov 7, 1994
 Kenneth L. Ross
 Mason County Surveyor

(NOTE: Corner is accepted as the best evidence of the perpetuated location of the original corner).

Signed by John C. Schulke Date Nov 7, 1994

Surveyor's Michigan License No. PLS-30894

FORM APPROVED BY MICHIGAN STATE BOARD OF LAND SURVEYORS, JAN. 28, 1971
 and Approved
 Date: Feb 25 1997
 Kenneth L. Ross