

MAR 16 1998

LAND CORNER RECORDATION CERTIFICATE

Filing Requirement of Act 74, Mich. P.A. 1970

SECTION
For corners in
MASON
(County)

Located In:

Corner Code #

- 1. Public Land Survey T 19N R 15W
T R
T R
T R
- 2. Property Controlling in Section S T R
S T R
- 3. Miscellaneous Property in Sec. S T R
S T R

1-12

Seg. #2

FILED
AT 2:55 O'CLOCK P M
JUN - 5 1997
MARY GOLDEN KOLASKI
MASON COUNTY
REGISTER OF DEEDS
Register of Deeds Stamp & File Number

- 4. Lot No. _____ Recorded Plat _____
- 5. Private Claims _____

I, Richard Hays, in a field survey on May 5, 19 97, do hereby certify that under requirements of P.A. 74, Michigan P.A. of 1970, the corner points mentioned in lines 1 and 2 above were in conformance with regulations and rules therefore as required in the current manual of survey instructions of the United States Department of the Interior, Bureau of Land Management or by a decree of a Court of Law and/or that the corner points mentioned in lines 3, 4 and 5 above were in conformance with the rules of the Michigan Board of Land Surveyors or by a Decree of a Court of Law; established, re-established, monumented, re-monumented, recovered, found as expressed below:

NOTE: Not more than 4 corners, all in the same town and range, may be recorded on this certificate.

A. Description of original monument and accessories and/or subsequent restoration:

Original survey established in 1838 by Sibley.
Set wood post with the following references:
1. Beach 12" N 59° E 27 lks.
2. Maple 12" S 42° W 10 lks.

In 1938, Survey by Lunde set Iron Stake.
5. corner fence post (steel) N 66° W 37.90 ft.
6. NE Corner of Sec. 34 N 01° W 2566.00'
7. SE Corner of Sec. 34 S 01° E 2566.00'

In 1896, J. W. Grisvold (see Book 1, Page 203) set by measurement, no ties recorded.
3. NE corner of Section 34 North 38.89 chains
4. SE corner of Section 34 South 38.99 chains

In 1984, Dennis Dunlap found Iron (see corner certificate liber 2, page 222)

B. Description of corner evidence found and/or method applied in restoring or reestablishing corner:

Found 1" Iron Pipe pinch on the bottom.

NE corner of Section 34 N 00° 53' 00" E 2665.27 ft. (Grid bearing & distance)
SE corner of Section 34 S 00° 53' 27" W 2665.92 ft. (Grid bearing & distance)

Note: References #1 and #2 were not recovered.

C. Description of monument for corner and accessories established to perpetuate locating the position of the corner:


I replaced 1" Iron Pipe, in the exact location, with a 5/8" Re-Rod with an aluminum cap monument stamped to identify the corner. The monument is placed one foot below the surface of the road. The center-line of Taylor road is 3 feet West and the center-line of Stolberg road is 3 feet South.

The following corner references:
Chiseled "X" on a Boulder 6' x 4' x 3' S 60° W 60.13 ft.
Power pole N 40° E 31.93 ft.
Power pole N 41° W 39.35 ft. (gone)
Power pole N 40° E 41.12 ft. (new May 97)
Ash 18" S 14° E 101.90 ft.
Red Oak 18" N 30° W 113.52 ft.

(Note: accepted as a careful and faithful re-establishment of the position of the original corner.)

Signed by Richard Hays Date May 14, 1997

Surveyor's Michigan License No. 25847

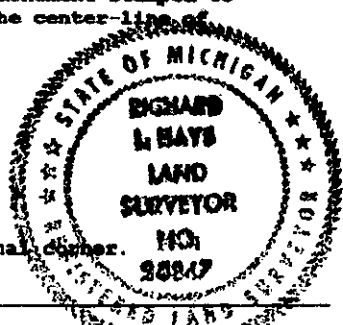

FORM APPROVED BY MICHIGAN STATE BOARD OF LAND SURVEYORS JUL 28, 1971
REVISED MAY 14, 1976
REVISED JAN. 1983
ADAPTED FOR WORD PROCESSING MARCH, 1983

Peer Group Reviewed
and Approved
Date: FEB 25 1997
Kenneth L. Ross
Mason County Surveyor