

LAND CORNER RECORDATION CERTIFICATE
Filing Requirement of Act 74, Mich. P.A. 1970

For corners in

MASON (County) Located In: Corner Code #


1. Public Land Survey T 19 N R 15 W 1-13
 T R
 T R
 T R
 T R

2. Property Controlling S T R
 In Section S T R

3. Miscellaneous S T R
 Property in Sec. S T R

4. Lot No. _____, Recorded Plat _____

5. Private Claims _____

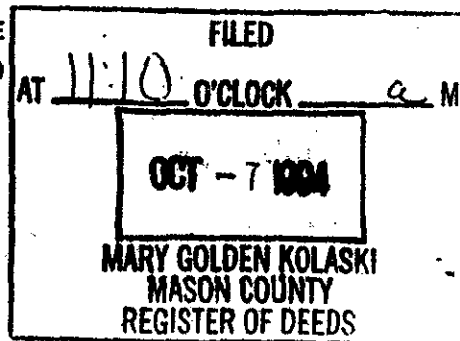

Register of Deeds Stamp & File Number

	A	B	C	D	E	F	G	H	I	J	K	L	M
2	6	5	4	3	2								
3													
4	7	8	9	10	11	12							
5													
6	18	17	16	15	14	13							
7													
8	19	20	21	22	23	24							
9													
10	30	29	28	27	26	25							
11													
12	31	32	33	34	35	36							
13													

I, Sammy S. Barnett, in a field survey on September 20, 1994, do hereby certify that under requirements of P.A. 74, Michigan P.A. of 1970, the corner points mentioned in lines 1 and 2 above were in conformance with regulations and rules therefore as required in the current manual of survey instructions of the United States Department of the Interior, Bureau of Land Management or by a decree of a Court of Law and/or that the corner points mentioned in lines 3, 4 and 5 above were in conformance with the rules of the Michigan Board of Land Surveyors or by a Decree of a Court of Law; established, re-established, monumented, re-monumented, recovered, found as expressed below:

NOTE: Not more than 4 corners, all in the same town and range, may be recorded on this certificate.

A. Description of original monument and accessories and/or subsequent restoration:

I-13 SouthWest corner, Section 35, on the Township Line

1838, G.L.O., John Mullette

Set wood post

#1 Maple 10" N 72° E 311k(20.46')

#2 Maple 6" N 41° W 241k(15.84')

1904 R.O. Towns, C.S.

Uses corner to set NW cor., Sec. 2
T18N - R15W

E. LUNDE

1938, K. Stephens, C.S.

Monument not given, used corner
in Survey in Sec. 34, T19N-R15W

1965, K. Stephens, C.S.

Replaced bent 1" iron pipe with
1" iron pipe

#3 S. Maple 8" NW 65.48'

#4 W. Oak 4" SE 22.34'

#5 Power Pole SW 39.25'

1971, R.A. Griffin, P.S.

Found 1" Iron Pipe, replaced with
5" squ. conc. Monument. (OVER)

B. Description of corner evidence found and/or method applied in restoring or reestablishing corner:

I-13 SouthWest corner, Section 35, on the Township Line

On September 20, 1994, I found 5" square x 36" Concrete Monument with 3" brass cap, found South of center-line of Decker Road 1foot below Road surface.

Condition of recorded witnesses is; #1 Gone #2 Gone #3 Gone #4 Gone #5 found in good cond.

#6 Gone #7 Gone #8 Same as #4 #9 Same as #5 #10 Found in fair cond. #11 Found in good cond.

**SURVEY &
REMONUMENTATION**

MAR 16 1998

SECTION

C. Description of monument for corner and accessories established to perpetuate locating the position of the corner:

I-13 SouthWest corner, Section 35, on the Township Line

Accepted 5" x 36" concrete monument with brass cap (U.S.F.S.) as a substancial marker for the corner, and is accepted as a careful and faithful reestablishment of the position of the original corner.

- (OBT #11) Center of brass cap of concrete monu, East 22.44'
- S. Maple Clump 10"-8" N 38° E 157.68' (60d spike in SE side of tree)
- R. Oak 5" N 23° W 157.20' (60d spike in NE side of tree)
- B. Oak 12" N 50° W 147.58' (60d spike in NE side of tree)

Signed by Sammy S. Barnett Date 10/4/94

Surveyor's Michigan License No. 16923


Peer Group Reviewed and Approved

Date: 10-5-94

Kenneth L. Ross
Mason County Surveyor

Peer Group Reviewed and Approved
FORM APPROVED BY MICHIGAN STATE BOARD OF LAND SURVEYORS, MAR. 28, 1971
DATE: SEP 25 1994
REVISIONS: MAY 14, 1975
REVISED JAN., 1983

Kenneth L. Ross
Mason County Surveyor

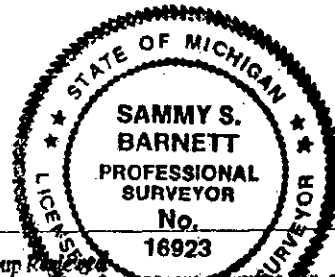

LIBER

3 PAGE 187