


LAND CORNER RECORDATION CERTIFICATE
 Filing Requirement of Act 74, Mich. P.A. 1970

For corners in


MASON (County) Located In: Corner Code #
 1. Public Land Survey T 19 N R 15 W J-7
 T R
 T R *Seq. 2*
 T R
 2. Property Controlling S T R
 In Section S T R
 3. Miscellaneous S T R **SURVEY & REMONUMENTATION**
 Property in Sec. S T R

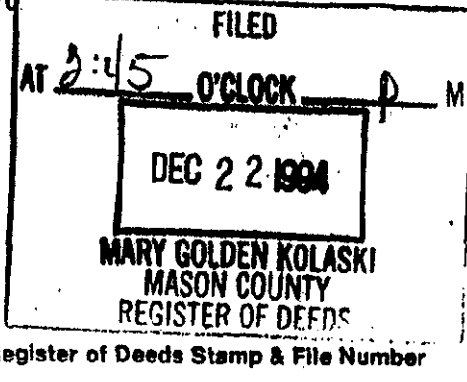

4. Lot No. _____, Recorded Plat MAR 16 1998
 5. Private Claims _____

SECTION

I, Sammy S. Barnett, in a field survey on October, 19 1994, do hereby certify that under requirements of P.A. 74, Michigan P.A. of 1970, the corner points mentioned in lines 1 and 2 above were in conformance with regulations and rules therefore as required in the current manual of survey instructions of the United States Department of the Interior, Bureau of Land Management or by a decree of a Court of Law and/or that the corner points mentioned in lines 3, 4 and 5 above were in conformance with the rules of the Michigan Board of Land Surveyors or by a Decree of a Court of Law; established, re-established, monumented, re-monumented, recovered, found as expressed below:

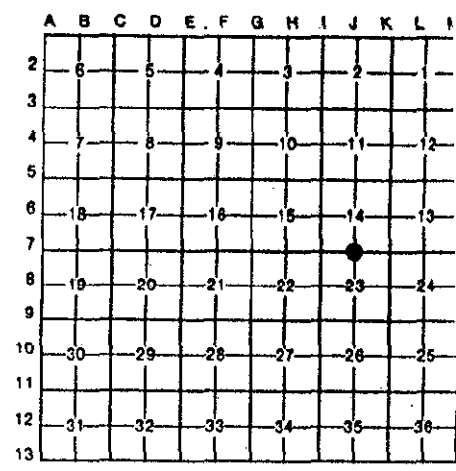

NOTE: Not more than 4 corners, all in the same town and range, may be recorded on this certificate.

A. Description of original monument and accessories and/or subsequent restoration:

- J-7 1/4 corner for Section 14 & 23, T 19 N, R 15 W
- | | | |
|---|--|--|
| <u>1838, G.L.O., Sylvester Sibley</u>
Set Wood Post | <u>#4 Pine Stp. 18" N 54° W 781k(51.48')</u>
Book 2, Pages 191 & 192
<u>1964, MCRC</u>
2" Iron Pipe | <u>1970, J. Borsfay MCRC</u>
Found 2" Iron Pipe |
| <u>#1 Pine 24" N 38° E 61k(3.96')</u> | <u>#5 Fence North 35.5'</u> | <u>#9 Blazed Oak 10" NW 79.29</u> |
| <u>#2 Beech 12" S 81° W 35(23.1')</u> | <u>#6 Elm 12" SE 57.7'</u> | <u>#10 Blzd. Poplar 12" SW 51.</u> |
| <u>1914, C.E. Mitchell, M.C.S.</u>
Found Stake & Witnesses | <u>#7 Tw. Maple SW 75.6'</u> | <u>#11 Maple Cls. SW 75.87'</u> |
| <u>#3 Pine Stp. 25" S 09° E 381k(25.08')</u> | <u>#8 Poplar (blue ring) South 39.00'</u> | <u>#12 Poplar 10" SE 57.66'</u> |

B. Description of corner evidence found and/or method applied in restoring or reestablishing corner:

J-7 1/4 corner for Section 14 & 23 T 19N, R 15 W

On November 2, 1994, I found 1/2" Re-Rod 4 foot North of center-line of Millerton Road, carefully removed Re-Rod to search for 2" Iron Pipe, found 2" Iron Pipe 4 foot below Road surface, left 2" Iron Pipe in ground. Found no conflicting evidence to disputed corner location.

Condition of recorded witnesses is; #1 Gone #2 Gone #3 Gone #4 Gone #5 Gone #6 Gone #7 Found in good cond. #8 Gone #9 Found in good cond. #10 Gone #11 Same as 7 #12 Gone #13 & 14 #15 Found in good cond. #16 Same as 9 #17 Found in good cond. #18 Same as 9 #19 Same as 17 #20 Found in good cond.

C. Description of monument for corner and accessories established to perpetuate locating the position of the corner:

J-7 1/4 corner for Section 14 & 23, T 19 N, R 15 W

Replaced 1/2 " Re_Rod with 5/8" x 24" Re-Rod with a 2 1/2" aluminum cap, stamped MASON COUNTY MONUMENT, 1 foot below the surface (gravel) of the Road, and is a careful and faithful reestablishment of the position of the original corner.

(OBT #9) W. Oak 20" N 46° W 79.33' (60d spike in SW side of tree)
(OBT#15) W. Pine 9" S 38° W 65.88' (60d spike in SE side of tree)
(OBT#17) Cherry 5" N 02° E 39.60' (60d spike in NW side of tree)
W. Oak 5" S 28° E 66.52' (60d spike in NE side of tree)

Peer Group Reviewed and Approved
 Date: 11-14-94
 Kenneth L. Ross
 Mason County Surveyor

Signed by Sammy S. Barnett Date 11-14-94

Surveyor's Michigan License No. 16923
 Peer Group Reviewed and Approved
 Date: 11-14-94
 Kenneth L. Ross
 Mason County Surveyor



FORM APPROVED BY MICHIGAN STATE BOARD OF PROFESSIONAL SURVEYORS MAY 14, 1975 REVISED JAN., 1983