

**SURVEY &  
REMONUMENTATION**

**MAR 16 1998**


**LAND CORNER RECORDATION CERTIFICATE**

Filing Requirement of Act 74, Mich. P.A. 1970

For corners in **SECTION**  
Mason  
(County)

Located in: Corner Code #

- 1. Public Land Survey T 19N R 16W B-1
- 2. Property Controlling in Section S \_\_\_\_\_ T \_\_\_\_\_ R \_\_\_\_\_
- 3. Miscellaneous S \_\_\_\_\_ T \_\_\_\_\_ R \_\_\_\_\_  
Property in Sec. S \_\_\_\_\_ T \_\_\_\_\_ R \_\_\_\_\_
- 4. Lot No. \_\_\_\_\_ Recorded Plat \_\_\_\_\_
- 5. Private Claims \_\_\_\_\_

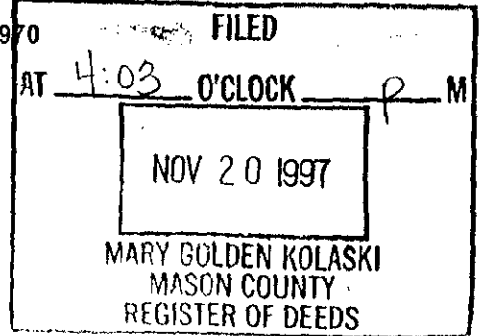

Register of Deeds Stamp & File Number

I, Richard L. Hays, in a field survey on Oct 1997, do hereby certify that under requirements of P.A. 74, Michigan P.A. of 1970, the corner points mentioned in lines 1 and 2 above were in conformance with regulations and rules therefore as required in the current manual of survey instructions of the United States Department of the Interior, Bureau of Land Management or by a decree of a Court of Law and/or that the corner points mentioned in lines 3, 4 and 5 above were in conformance with the rules of the Michigan Board of Land Surveyors or by a Decree of a Court of Law, established, re-established, monumented, re-monumented, recovered, found as expressed below:

**NOTE: Not more than 4 corners, all in the same town and range, may be recorded on this certificate.**

A. Description of original monument and accessories and/or subsequent restoration:  
B-1 NORTH QUARTER CORNER SECTION 6 (CLOSING CORNER) T19N-R16W  
This Corner was not established by G.L.O. Survey  
1983: L.C.R.C. Lawrence Slater RLS #7439  
Set 7/8" square iron, 28' long 2' North of the centerline of Townline Road.  
Lode Stone with chiseled "X" on top N-87°-20'-09"-W 14.53'  
This corner was established using improper procedures and is not utilized in this survey.  
  
1992 John C. Schulke R.L.S. 30894 Section Survey Set 1 1/2" diameter Iron Pipe for Corner. No Witnesses.

B. Description of corner evidence found and/or method applied in restoring or reestablishing corner:  
B-1 NORTH QUARTER CORNER SECTION 6 (CLOSING CORNER) T19N-R16W  
October 1997: Found 1-1/2" Iron Pipe 25.01' East of Standard Corner.  
Computed Location between Controlling Corners was 24.95'

C. Description of monument for corner and accessories established to perpetuate locating the position of the corner:  
B-1 NORTH QUARTER CORNER SECTION 6 (CLOSING CORNER) T19N-R16W  
October 1997: Replaced 1-1/2" Iron Pipe with a Standard Mason County Monument and accepted this location as the best available evidence of the position of the Corner and took the following Witnesses:

1/2" Re-Rod	N-49°-E	18.81'
1/2" Re-Rod	S-23°-E	19.28'
1/2" Re-Rod	S-38°-W	19.81'
1/2" Re-Rod by steel gate post	N-42°-W	42.55'
Standard Corner	West	25.01'
Southeast Corner	East	2646.16'
Southwest Corner	West	2536.35'

	A	B	C	D	E	F	G	H	I	J	K	L	M
1													
2	6	5	4	3	2	1							
3													
4	7	8	9	10	11	12							
5													
6	18	17	16	15	14	13							
7													
8	19	20	21	22	23	24							
9													
10	30	29	28	27	26	25							
11													
12	31	32	33	34	35	36							
13													

Signed by Richard Hays Date 11/6/97

Surveyor's Michigan License No. 25847

